IREDELL COUNTY HEALTH DEPARTMENT

Statesville Phone TR 3-7271 Mooresville Phone NO 3-1271

PERMIT TO INSTALL SEPTIC TANK

Permit NO._____ Permit Date July 1968

Owner Bob Spaulding Address S. Statesville N.C.

Installed By Sam Beard Address Harmony N.C.


Location of Property Oak street to eighth on east broad St. Extension before Hyw. 64 last house on left at dead end

Tank		Capacity		Length of Lines		Fixtures	
Block	( )	1000	( )	225'	( )	No. of Baths	( )
Precast	( )	1250	( )	250'	( )	Dishwasher	( )
		1500	( )	Other_____		Garbage Grdr.	( )
		Other_____				Other_____	

NOTIFY HEALTH DEPARTMENT AT LEAST EIGHT HOURS BEFORE TANK IS TO BE INSPECTED.

Final Inspection_____ 19__ Approved ( ) Disapproved ( )

Remarks _____

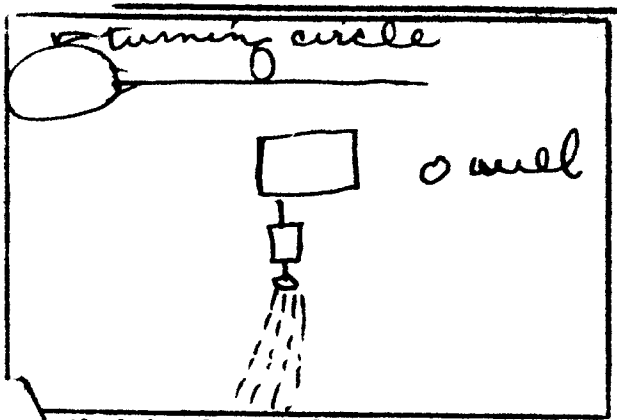

Sketch of Installation

Sanitarian