IREDELL COUNTY HEALTH DEPARTMENT

Statesville Phone TR 3-7271 Mooresville Phone No. 664-5281

PERMIT TO INSTALL SEPTIC TANK

Permit Date 7-26 1973

Permit No. 1221

Owner Bldr. BOAN Bldg. Co. Address STATESVILLE, NC

Installed By Raymond Adams Address Hiddenite, N.C.

Location of Property BROOKMEADE Dr. off E. Broad St.


Ext. Corner LANCASTER Dr. & BROOKMEADE Dr.

Tank		Capacity		Length of Lines		Fixtures	
Block	( )	1000	( )	225'	( )	No. of Baths	( )
Precast	(✓)	1250	( )	250'	( )	Dishwasher	(✓)
		1500	( )	Other 240		Garbage Grdr.	( )
		Other				Other	

NOTIFY HEALTH DEPARTMENT AT LEAST EIGHT HOURS BEFORE TANK IS TO BE INSPECTED.

Final Inspection 7-26 1973 Approved ( ) Disapproved ( )

Remarks IREDELL WATER Corp.

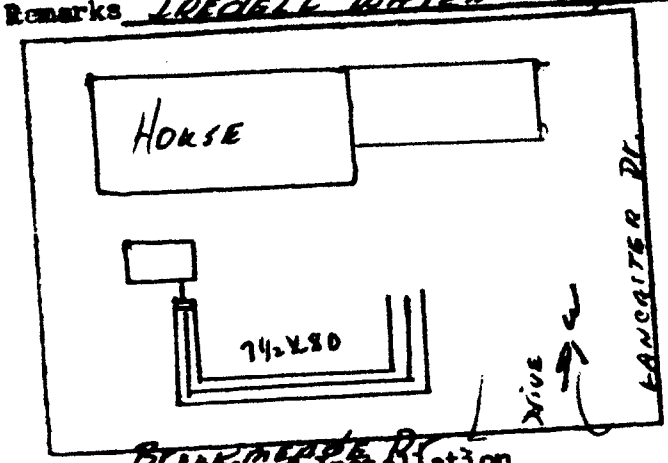

Sketch of Installation

Sanitarian