IREDELL COUNTY HEALTH DEPARTMENT

Statesville Phone TR 3-7271 Mooresville Phone NO 3-1271

PERMIT TO INSTALL SEPTIC TANK

Permit NO. 4 Permit Date 12-23 1969

Owner Expressway Catering Address Rt 5 Statesville, N.C.

Installed By Nation & Cockrell Address Rt 5 Statesville, N.C.


Location of Property Hwy 64 E

Tank		Capacity		Length of Lines		Fixtures	
Block	( )	1000	(✓)	225'	( )	No. of Baths	( )
Precast	( )	1250	( )	250'	( )	Dishwasher	( )
		1500	( )	Other 480 sq ft		Garbage Grdr.	( )
		Other				Other	

NOTIFY HEALTH DEPARTMENT AT LEAST EIGHT HOURS BEFORE TANK IS TO BE INSPECTED.

Final Inspection 12-23 1969 Approved (✓) Disapproved ( )

Remarks Green tank Installed 10 inches of Stone no well in use in property

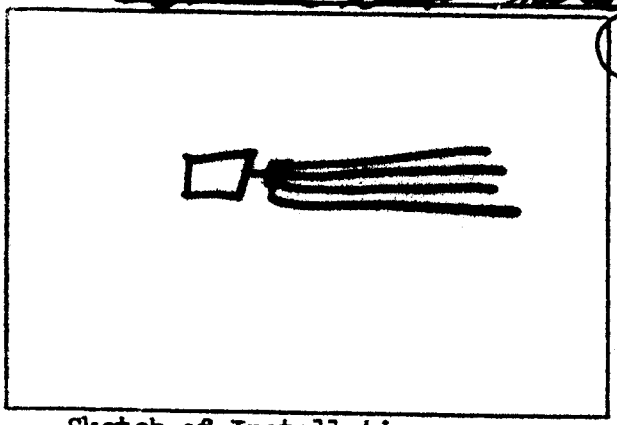

Sketch of Installation

W. Brent Hutchens R.S.

Sanitarian