IREDELL COUNTY HEALTH DEPARTMENT

STATESVILLE 704-878-5305 MOORESVILLE 704-664-5281

IMPROVEMENT PERMIT / AUTHORIZATION TO CONSTRUCT / OPERATION PERMIT / EXISTING SYSTEM INSPECTION

PERMIT# 92510 PIN# 4765 332075 PT DATE 11/3/00

OWNER OR CONTRACTOR DOUG HENSHAW PHONE: Business Home

ADDRESS MILLS GARDEN RD STATESVILLE

LOCATION I40 EAST - 64 E - TR BROAD ST - JUST ON LEFT.

SUBDIVISION - BLOCK / SECTION - LOT - LOT AREA ~3AC SITE CLASS FS DESIGN FLOW 300GPD L.T.A.R. ~.15 gal/ft²

Septic Tank: 1000 Gallons; STB 1012 Date 8-31-00
Pump Tank: 1000 Gallons; PT Date
Pump Make: Model Serial No.
Nitrification Field: No Fields 1 Square Feet 240 Linear Feet 120
No Lines 4@30' Trench Width ~~20~~ 24" Max Trench Bottom Depth 36" Gravel Depth N/A

☑ New System ☐ Repair System Type: I, II, (III) IV, V, VI
System Description: PUMP PANEL
Repair System Description: SAME
Maintenance Agreement Required: ☐ Yes ☑ No


☐ House/Mod. Home No. Bedrooms
☐ Mobile Home No. Bathrooms
☑ Business No. Employees 1
☐ Other
☑ Slab ☐ Crawl Space ☐ Basement w/plumbing ☐ Basement wo/plumbing

Water Supply: ☐ Individual ☑ Public ☐ Community


Comments/Conditions: 1) SYSTEM IS PUMPED AFTER CONSTRUCTION IF GRAVITY CAN BE ACHIEVED PERMIT WILL BE CHANGED 3) ADD FRENCH DRAIN AROUND SYSTEM.

Comments/Conditions:

INITIAL SITE SKETCH

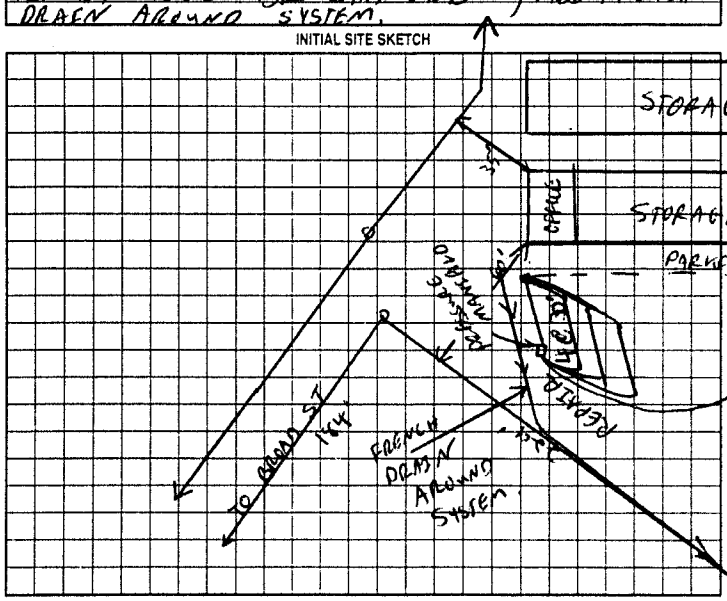

AS BUILT SKETCH

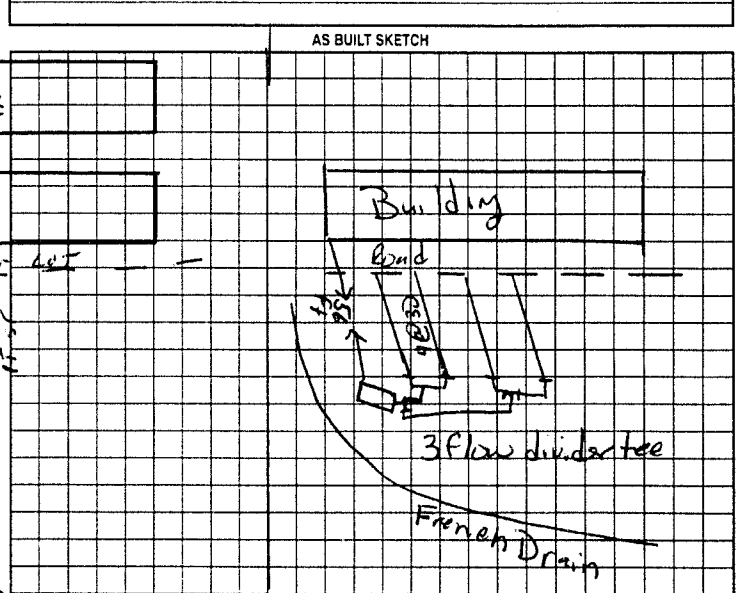

Permit can be suspended or revoked if any false information is supplied toward securing the permit/any unauthorized changes are made to the site/any unauthorized changes are made in the installation of the system. Improvement Permit with plat valid without expiration. Improvement Permit with site plan valid for sixty months. Authorization to Construct is valid for a period equal to that of Improvement Permit - not to exceed sixty months.

Signed: [signature] date 11/3/00 Installed by: Steve Jordan

Improvement Permit by: [signature] date 11/3/00 Operation Permit by: [signature] date 1-02-01

Authorization to Construct by: [signature] date 11/3/00 Existing System Inspection by: date

HEALTH DEPT. COPY: WHITE OWNER COPY (FINAL): YELLOW OWNER COPY (INITIAL): PINK