IREDELL COUNTY HEALTH DEPARTMENT STATESVILLE 704-878-5305 MOORESVILLE 704-664-5281

IMPROVEMENT PERMIT / AUTHORIZATION TO CONSTRUCT / OPERATION PERMIT / EXISTING SYSTEM INSPECTION

PERMIT# 87060 PIN# 4765284975 DATE 1-10-00

OWNER OR CONTRACTOR Jonathan Johnson PHONE: Business 902 4037 Home 878 2987

ADDRESS 176 Journeys End Rt Statesville, N.C.

LOCATION Old Mocksville TR Beaver Fm TR Journeys End 1/2 mi Rt.

SUBDIVISION _____ BLOCK / SECTION _____ LOT _____ LOT AREA 3.1 acres SITE CLASS PS DESIGN FLOW 360 L.T.A.R. .3

Septic Tank: 1000 Gallons: STB 1012 Date 10/29/99
Pump Tank: _____ Gallons: PT _____ Date _____
Pump Make: _____ Model _____ Serial No. _____
Nitrification Field: No Fields 1 Square Feet 630 Linear Feet 210
No Lines 2 Trench Width 36" Max Trench Bottom Depth 36" Gravel Depth 12"


☐ New System ☑ Repair System Type: I ☐ II ☐ III ☐ IV ☐ V ☐ VI
System Description: Initial Conv. Gravity
Repair System Description: " "
Maintenance Agreement Required: ☐ Yes ☑ No
☐ Slab ☐ Crawl Space ☐ Basement w/plumbing ☐ Basement wo/plumbing

☑ House/Mod. Home No. Bedrooms 3
☐ Mobile Home No. Bathrooms 2
☐ Business No. Employees _____
☐ Other _____

Water Supply: ☑ Individual ☐ Public ☐ Community


Comments/Conditions: 163

INITIAL SITE SKETCH

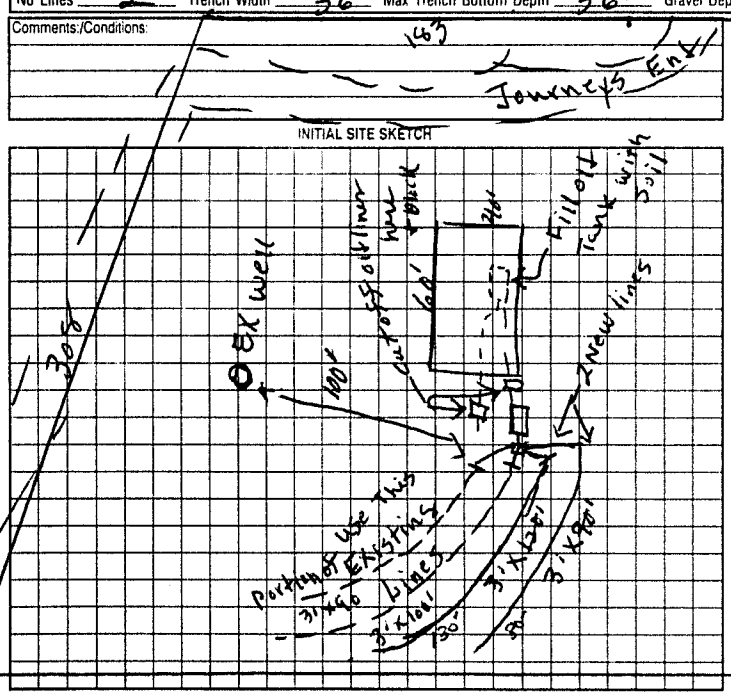

Comments/Conditions: 134
Replacing 2 BR mit With 3 BR House

AS BUILT SKETCH

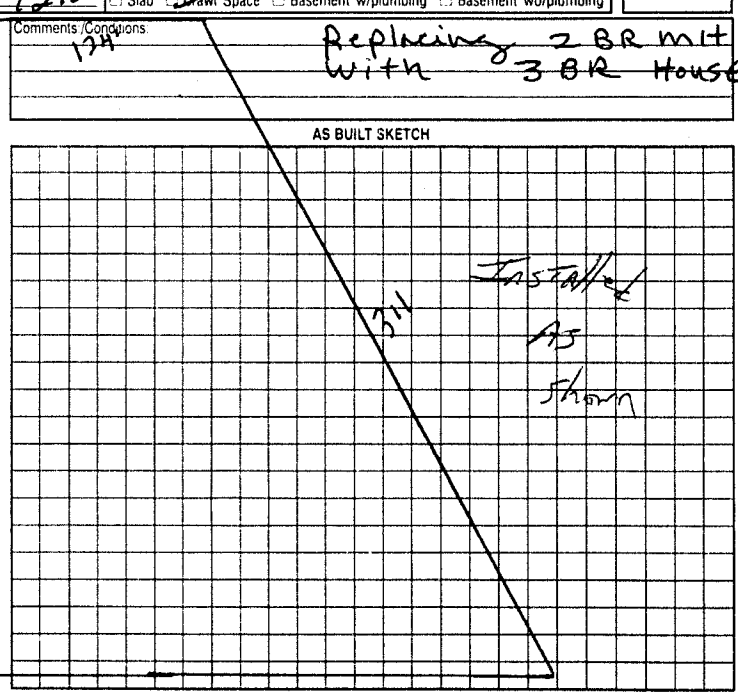

Permit can be suspended or revoked if any false information is supplied toward securing the permit/any unauthorized changes are made to the site/any unauthorized changes are made in the installation of the system. Improvement Permit with plat valid without expiration. Improvement Permit with site plan valid for sixty months. Authorization to Construct is valid for a period equal to that of Improvement Permit – not to exceed sixty months.

Signed: Jonathan C. Johnson date 1-10-00 Installed by: AT Backhoe

Improvement Permit by: R. C. Moore date 1-10-00 Operation Permit by: C Bates date Feb 8 2000

Authorization to Construct by: R. C. Moore date 1-10-00 Existing System Inspection by: _____ date _____

HEALTH DEPT. COPY: WHITE OWNER COPY (FINAL): YELLOW OWNER COPY (INITIAL): PINK