IREDELL COUNTY HEALTH DEPARTMENT

STATESVILLE 704-878-5305 MOORESVILLE 704-664-5281

IMPROVEMENT PERMIT / AUTHORIZATION TO CONSTRUCT / OPERATION PERMIT / EXISTING SYSTEM INSPECTION

PERMIT# 93242 PIN# 4765304353 DATE 8-10-99

OWNER OR CONTRACTOR Wayne Timothy Cape PHONE: Business 924-8883 Home

ADDRESS 297 S Triplett Rd Cleveland N.C.

LOCATION 64 E TR Bell Rd TR Hoots at end on Rt.

SUBDIVISION BLOCK / SECTION LOT LOT AREA 1.04 acres SITE CLASS PS DESIGN FLOW 360 L.T.A.R. .27

Septic Tank: 1000 Gallons; STB 16 Date 2/9 00
Pump Tank: Gallons; PT Date
Pump Make: Model Serial No.
Nitrification Field: No Fields 1 Square Feet 1350 Linear Feet 450
No Lines 3 Trench Width 36" Max Trench Bottom Depth 24" Gravel Depth 12"

☑ New System ☐ Repair System Type: I (II) III, IV, V, VI
System Description: Conv. Gravity
Repair System Description: Gravity 25% Reduction
Maintenance Agreement Required: ☐ Yes ☑ No


☑ House/Mod. Home No. Bedrooms 3
☐ Mobile Home No. Bathrooms 2
☐ Business No Employees
☐ Other
☐ Slab ☐ Crawl Space ☑ Basement w/plumbing ☐ Basement wo/plumbing

Water Supply: ☐ Individual ☑ Public ☐ Community


Comments/Conditions:

Comments/Conditions Drop boxes located at Line ends due to home. Shift 10ft short by my tape 450 ft of pipe installed

INITIAL SITE SKETCH

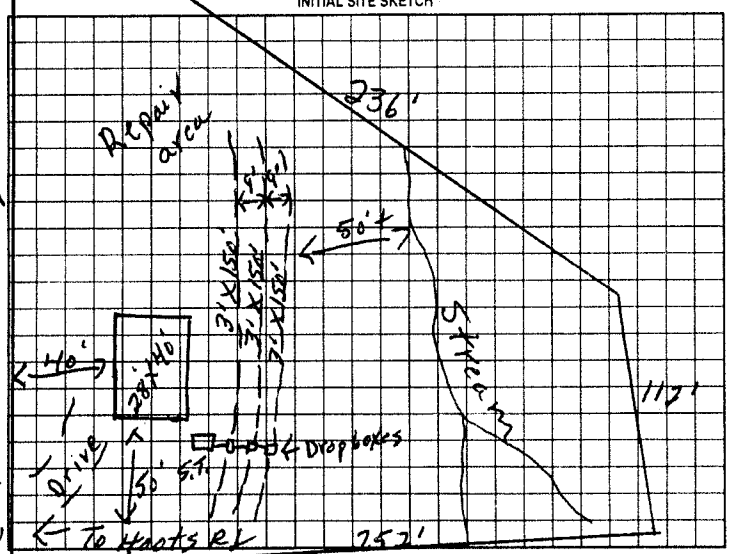

AS BUILT SKETCH

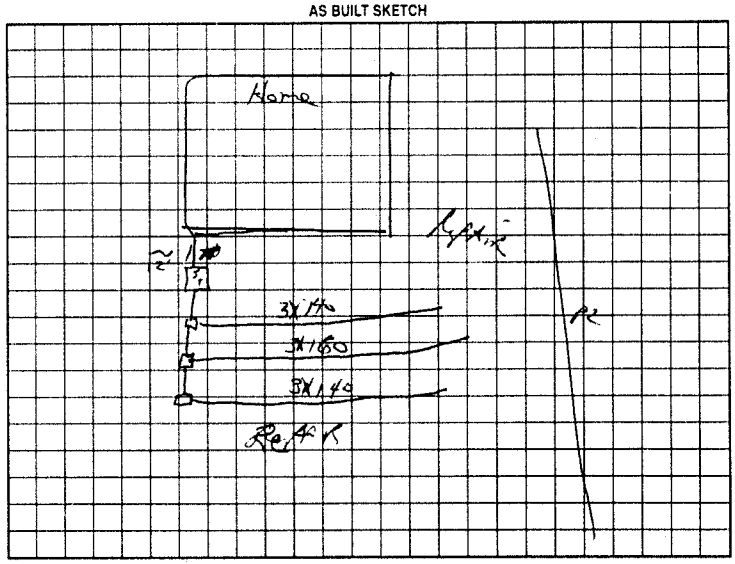

Permit can be suspended or revoked if any false information is supplied toward securing the permit/any unauthorized changes are made to the site/any unauthorized changes are made in the installation of the system. Improvement Permit with plat valid without expiration. Improvement Permit with site plan valid for sixty months. Authorization to Construct is valid for a period equal to that of Improvement Permit – not to exceed sixty months.

Signed: X. Wayne Cape date

Improvement Permit by: J.C. Moore date 8-10-99

Authorization to Construct by: J.C. Moore date 8-10-99

Installed by: Andy Daniels Backhoe

Operation Permit by: [signature] date 5-1-00

Existing System Inspection by: date

HEALTH DEPT. COPY: WHITE OWNER COPY (FINAL): YELLOW OWNER COPY (INITIAL): PINK