IREDELL COUNTY HEALTH DEPARTMENT

Statesville Office (704) 878-5305 Mooresville Office (704) 660-3625 PERMIT # 224159

IMPROVEMENT PERMIT / AUTHORIZATION TO CONSTRUCT / OPERATION PERMIT / EXISTING SYSTEM

PIN # 4765-30-8800

APPLICANT: Margaret Carter APPLICANT ADDRESS: 142 Carter Lane Statesville, NC 28625

SITE ADDRESS: 142 Carter Lane Statesville, NC 28625 PHONE: 704-873-5155 ALT. PHONE: 704-657-4422 (Candy) - Daughter

SITE DIRECTIONS: Rt. 64 East from Statesville → R on Bell Farm Rd → R on Carter Lane → House @ end of Cul-de-sac

SUBDIVISION: — SECTION: — LOT # — LOT AREA: 2.93 acres DESIGN FLOW: 360 GPD L.T.A.R.: 0.30

Septic Tank 1000 (gal) STB 960 Date 9-6-16
Pump Tank — (gal) PT — Date —
Pump Make — Model — Serial # —
Nitrification Fields 1 # Lines 4 Linear Ft: 300
Trench Width 36" Trench Bottom Depth 26"-30" High side Gravel Depth —


☐ New System ☒ Repair ☐ Expansion System Type: I II (III) IV V VI
System Description: —
Repair System Description: Tank + 25% Reduction
Maintenance Agreement Required: ☐ YES ☒ NO
☒ GRAVITY ☐ PRESSURE

☒ Residence ☐ Business ☐ Other ☐ Slab ☒ Basement w/plumbing
No. Bedrooms 3 No. Persons 6 No. Employees — ☒ Crawl Space
☐ Basement w/o plumbing


Water Supply: ☐ Private ☒ Public ☐ Community

Comments / Conditions: Follow all N.C. septic rules. Recommend pumping the septic tank every 3-5 years. Old Septic tank to be pumped & crushed in place. Recommend adding hydrated lime to all exposed sewage surfaces.

INITIAL SITE SKETCH

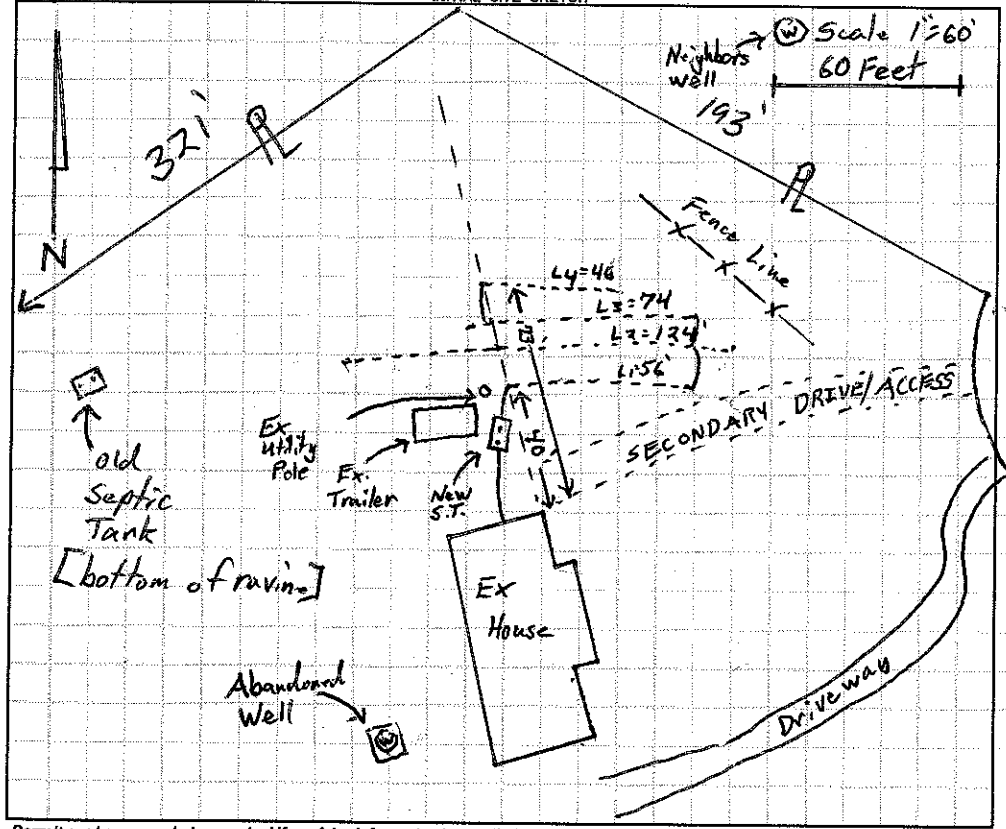

AS BUILT SKETCH

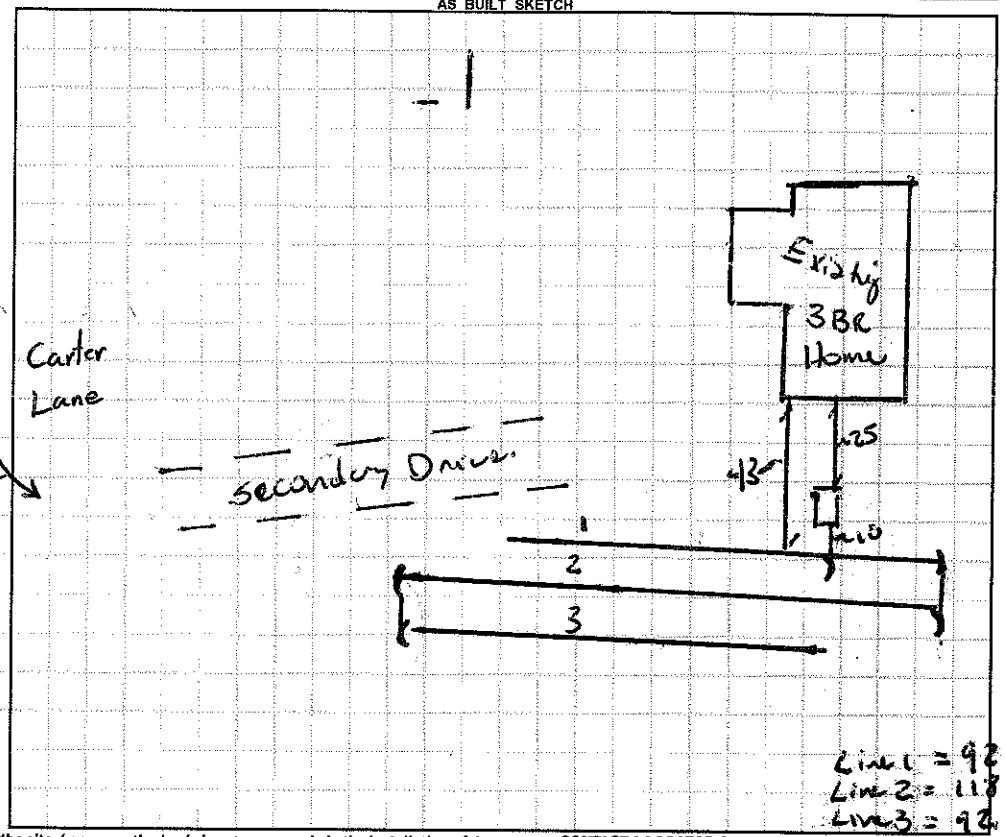

Permit can be suspended or revoked if any false information is supplied toward securing the permit / any unauthorized changes are made to the site / any unauthorized changes are made in the installation of the system. **CONTACT A LOCATOR SERVICE PRIOR TO ANY EXCAVATION**

☐ **IMPROVEMENT PERMIT** *with plat valid without expiration.* ☒ **IMPROVEMENT PERMIT** *with site plan valid for 60 mos.* ☒ **AUTHORIZATION TO CONSTRUCT** *valid for period equal to IMPROVEMENT PERMIT--not to exceed 60 mo.*

Owner / Applicant Signature: Margaret Carter Date: 3/2/17 Installed by: Lutz Wastewater

IMPROVEMENT PERMIT by: Tom Shuck Date: 3/2/17 OPERATION PERMIT by: B. Bothwell Date: 3/24/17

AUTHORIZATION TO CONSTRUCT by: Tom Shuck Date: 3/2/17 Existing System Inspected by: — Date: —

Health Dept. Copy - WHITE Applicant (Final Approval) - YELLOW Applicant (Conditional Approval) - PINK