# IREDELL COUNTY HEALTH DEPARTMENT

Statesville Office (704) 878-5305 Mooresville Office (704) 660-3625 PERMIT # 178402

## IMPROVEMENT PERMIT / AUTHORIZATION TO CONSTRUCT / OPERATION PERMIT / EXISTING SYSTEM

PIN # 4765324563

APPLICANT: David Yountz APPLICANT ADDRESS: 422 White Oak Branch

SITE ADDRESS: 3522 Cambridge Place - Sta 28625 PHONE: 704-902-9852 ALT. PHONE:

SITE DIRECTIONS: E Broad St to R on Brookmeade, (L) on Cambridge

SUBDIVISION: Brookmead SECTION: 4 LOT # 4 LOT AREA: 1 n/a DESIGN FLOW: 360 L.T.A.R.: .25

ENTERED

| | | | | | | | |
|---|---|---|---|---|---|---|---|
| Septic Tank | Ex (gal) | STB | Ex. | Date | | | |
| Pump Tank | (gal) | PT | | Date | | | |
| Pump Make | | Model | | Serial # | | | |
| # Nitrification Fields | 1 | # Lines | 6 | Linear Ft: | 300' | | |
| Trench Width | 36 | Max. Trench Bottom Depth | 36 | Gravel Depth | | | |

☐ New System ☒ Repair ☐ Expansion System Type: I II (III) IV V VI

System Description:

Repair System Description: 25% Reduction

Maintenance Agreement Required: ☐ YES ☒ NO

☒ GRAVITY ☐ PRESSURE

☒ Residence ☐ Business ☐ Other ☐ Slab ☐ Basement w/ plumbing

No. Bedrooms 3 No. Persons No. Employees ☒ Crawl Space ☐ Basement w/o plumbing


Water Supply: ☐ Private ☒ Public ☐ Community

Comments / Conditions:

Water usage a potential issue - water entered tank continually during installation - possible leak or overusage for system size
- Ground wet during installation.

INITIAL SITE SKETCH

AS BUILT SKETCH

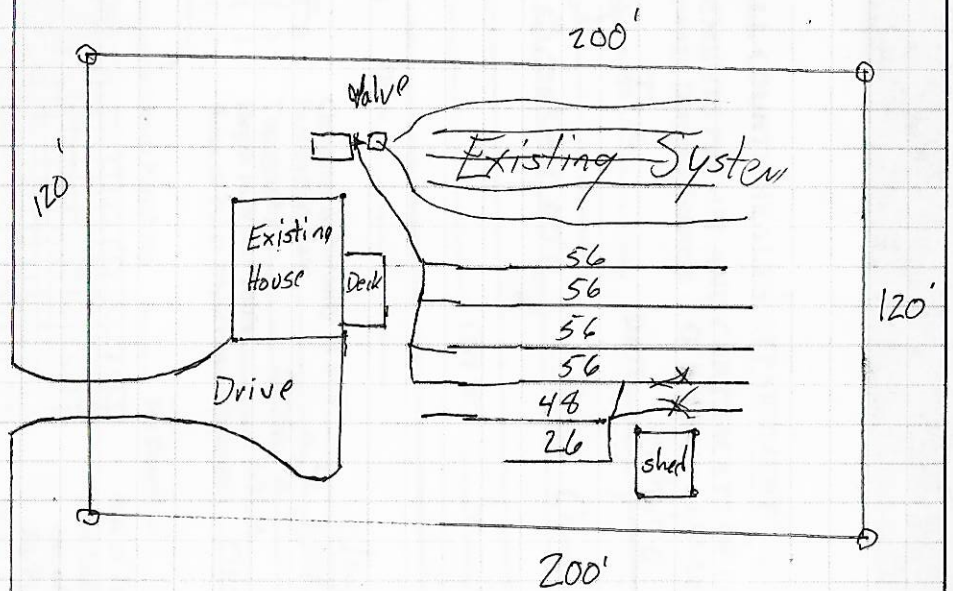


Installed new tee in tank.

*Permit can be suspended or revoked if any false information is supplied toward securing the permit / any unauthorized changes are made to the site / any unauthorized changes are made in the installation of the system.* **CONTACT A LOCATOR SERVICE PRIOR TO ANY EXCAVATION**

☐ **IMPROVEMENT PERMIT** *with plat valid without expiration.* ☒ **IMPROVEMENT PERMIT** *with site plan valid for 60 mos.* ☒ **AUTHORIZATION TO CONSTRUCT** *valid for period equal to IMPROVEMENT PERMIT--not to exceed 60 mo.*

Owner / Applicant Signature: David Yountz Date: Installed by: David Yountz Grading

IMPROVEMENT PERMIT by: Date: 5-10-13 OPERATION PERMIT by: Date: 5-10-13

AUTHORIZATION TO CONSTRUCT by: Date: 5-10-13 Existing System Inspected by: Date:

Health Dept. Copy - WHITE Applicant (Final Approval) - YELLOW Applicant (Conditional Approval) - PINK