IREDELL COUNTY HEALTH DEPARTMENT

STATESVILLE 704-878-5305 MOORESVILLE 704-664-5281

IMPROVEMENT PERMIT / AUTHORIZATION TO CONSTRUCT / OPERATION PERMIT / EXISTING SYSTEM INSPECTION

CI

PERMIT# 131608 PIN# 4765-32-7743 DATE 10-24-05

OWNER OR CONTRACTOR MOOREFIELD BUILDERS PHONE: Business 704-880-6620 Home 704-873-7885

ADDRESS 1516 MOCKSVILLE HWY STATESVILLE NC 28625

LOCATION 64 WEST (R) [redacted] EAST BROAD ST (L) BROOKMEADE (L) CAMBRIDGE AT END ON LEFT

SUBDIVISION BROOKMEADE BLOCK / SECTION ____ LOT 9 LOT AREA 1.616 SITE CLASS PS DESIGN FLOW 360 L.T.A.R. .35

Septic Tank: 1000 Gallons; STB 1012 Date 9-6-05
Pump Tank: ____ Gallons; PT ____ Date ____
Pump Make: ____ Model ____ Serial No. ____
Nitrification Field: No Fields 1 Square Feet EO=1440' Linear Feet 360
No Lines 3 Trench Width 36" Max Trench Bottom Depth 18" Gravel Depth N/A

☒ New System ☐ Repair System Type: I, II, (III), IV, V, VI
System Description: GRAY 25% REDUCT
Repair System Description: LP 50% REDUCT
Maintenance Agreement Required: ☐ Yes ☒ No


☒ House/Mod. Home No. Bedrooms 3/2
☐ Mobile Home No. Bathrooms
☐ Business No. Employees
☐ Other

☐ Slab ☒ Crawl Space ☐ Basement w/plumbing ☐ Basement wo/plumbing

Water Supply: ☐ Individual ☒ Public ☐ Community

Comments/Conditions: (1) MAINTAIN 18" TRENCH BOTTOM DEPTH ON THE LOW SIDE OF THE DITCH (2) KEEP HOUSE OUT OF GROUND & BALLED UP FOR POSITIVE Drainage in the FRONT YARD (3) MARK NEW SETBACKS (4) REDUCT

INITIAL SITE SKETCH

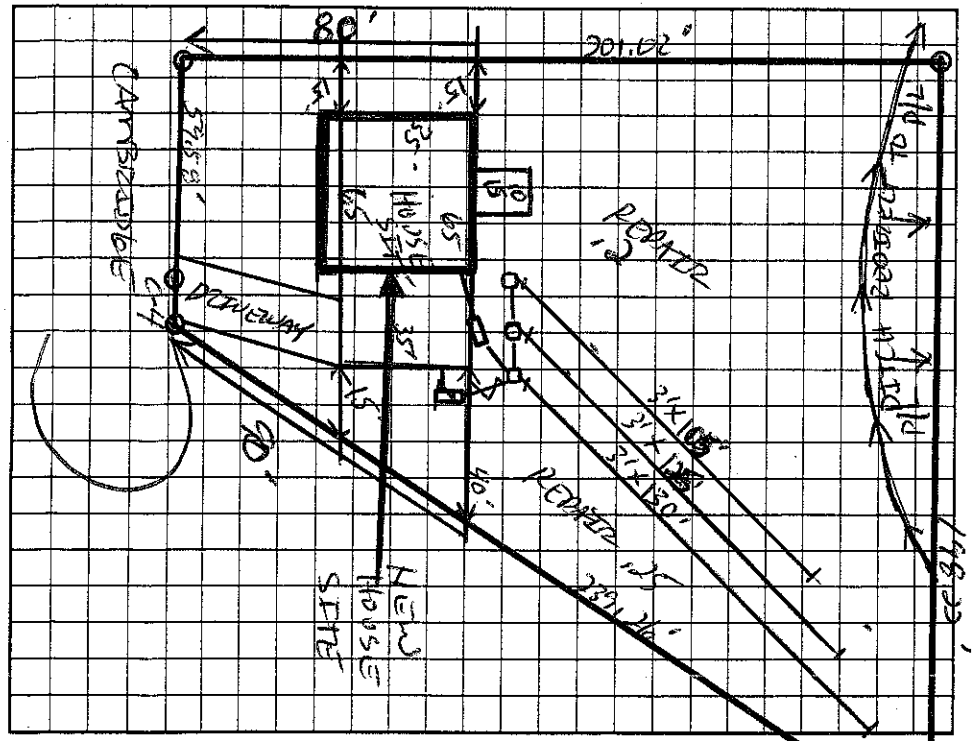

Comments/Conditions: DITCH TO PLAS DRAWN (5) MUST STUBOUT THRU GARAGE AS DRAWN
* MET WITH BUILDER & Approved 42'x40' 3 BEDROOM HOUSE PLAN. Keep Stubout 6" ABOVE NORMAL GRADE SO THAT CAN TANK AS BUILT SKETCH CAN BE ACHIEVED & 18" TRENCH BOTTOM DEPTH CAN BE ACHIEVED. IF NOT PUMP SYSTEM WILL Have to be achieved. INSPECTOR WILL VERIFY LINES & TANK INSTALLED AS DRAWN ELIMINATED DROP BOXES USED ONLY LINES TO DROP 4 CHAMBERS SO DEPTH OF 18" COULD BE ACHIEVED, BUILDER DID CHANGES, LC 3-28-06

Permit can be suspended or revoked if any false information is supplied toward securing the permit/any unauthorized changes are made to the site/any unauthorized changes are made in the installation of the system. Improvement Permit with plat valid without expiration. Improvement Permit with site plan valid for sixty months. Authorization to Construct is valid for a period equal to that of Improvement Permit – not to exceed sixty months.

Signed: ____ date ____ Installed by: Steve Jordan

Improvement Permit by: ____ date 10-24-05 Operation Permit by: ____ date 3-28-06

Authorization to Construct by: ____ date 10-24-05 Existing System Inspection by: ____ date ____

HEALTH DEPT. COPY: WHITE OWNER COPY (FINAL): YELLOW OWNER COPY (INITIAL): PINK