IREDELL COUNTY HEALTH DEPARTMENT

STATESVILLE 704-878-5305 — MOORESVILLE 704-664-5281

IMPROVEMENT PERMIT / AUTHORIZATION TO CONSTRUCT / OPERATION PERMIT / EXISTING SYSTEM INSPECTION

PERMIT# 114141 PIN# 4765 35 9903 DATE 10/21/03

OWNER OR CONTRACTOR LINDA KNOX PHONE: Business 336-766-3142 Home

ADDRESS 8184 HAWKINS RD - CLEMMONS NC 27012

LOCATION 64E - TL RIVERHILL - TL RIVERTON - ON LT

SUBDIVISION WEXFORD BLOCK / SECTION 2 LOT 3 LOT AREA .525 AC SITE CLASS. PS DESIGN FLOW 360GPD L.T.A.R. .36 PD/FT²

Septic Tank: 1000 Gallons; STB 1012 Date 1-15-07

Pump Tank: Gallons; PT Date

Pump Make: Model Serial No.

Nitrification Field: No Fields 1 Square Feet 1200 Linear Feet 400

No Lines 4@100' Trench Width 36" Max Trench Bottom Depth 36" Gravel Depth 12"

☑ New System ☐ Repair System Type: I, II, III, IV, V, VI

System Description: GRAVITY CONVENTIONAL

Repair System Description: GRAV/Pump 25% REDUCTION

Maintenance Agreement Required: ☐ Yes ☑ No

☑ House/Mod. Home No. Bedrooms 3

☐ Mobile Home No. Bathrooms 3

☐ Business No. Employees

☐ Other

☐ Slab ☑ Crawl Space ☐ Basement w/plumbing ☐ Basement wo/plumbing

Water Supply: ☐ Individual ☑ Public ☐ Community

Comments:/Conditions:


Comments:/Conditions:

300 100² 25% Reduction

yellow tub to the

end cap obstruction

INITIAL SITE SKETCH 1"=60'

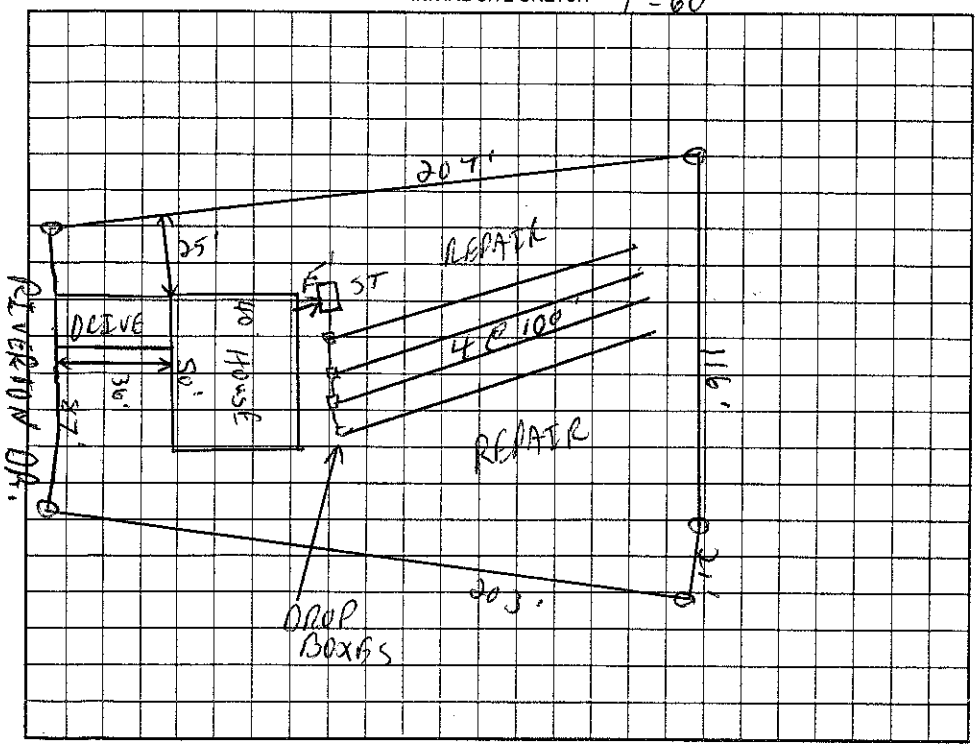

AS BUILT SKETCH

Permit can be suspended or revoked if any false information is supplied toward securing the permit/any unauthorized changes are made to the site/any unauthorized changes are made in the installation of the system. Improvement Permit with plat valid without expiration. Improvement Permit with site plan valid for sixty months. Authorization to Construct is valid for a period equal to that of Improvement Permit – not to exceed sixty months.

Signed: Linda W. Knox date 10-22-03

Improvement Permit by: RS date 10/21/03

Authorization to Construct by: date 3-8-07

Installed by: date

Operation Permit by: date 31 may 07

Existing System Inspection by: date

HEALTH DEPT. COPY: WHITE OWNER COPY (FINAL): YELLOW OWNER COPY (INITIAL): PINK