Mike Nystrom

IREDELL COUNTY HEALTH DEPARTMENT

* PERMIT REPLACES ONE [illegible]

STATESVILLE 704-878-5305 MOORESVILLE 704-664-5281

IMPROVEMENT PERMIT / AUTHORIZATION TO CONSTRUCT / OPERATION PERMIT / EXISTING SYSTEM INSPECTIO

PERMIT# 114174 PIN# 4765-38-8233 DATE 2-24-05

OWNER OR CONTRACTOR LINDA KNOX PHONE: Business (336) 766-3142 Home 704-400-2996 (N

ADDRESS 8184 HAWKINS CLEMMONS NC 27012

LOCATION DAVIE AVE TO US 64E TL RIVER HILL RD TL RIVERTON DR LOT AT END ON RT.

SUBDIVISION WEXFORD BLOCK / SECTION LOT 8 LOT AREA 0.463 SITE CLASS. PS DESIGN FLOW 360 L.T.A.R. 0.30 gpd/ft

Septic Tank: 1000 Gallons: STB 525 Date 1-21-05

Pump Tank: 1000 Gallons: PT 302 Date 2-17-05

Pump Make: GOULD Model WE05S12H Material No. J 04GAB11

Nitrification Field: No Fields 1 Square Feet 1200 Linear Feet 200

No Lines 3 Trench Width 24" Max Trench Bottom Depth 36"

☑ New System ☐ Repair System Type: I, II, III, ⓘ V, VI

System Description: LP PANEL 50% REDUCTION

Repair System Description: LP PANEL 50% REDUCTION

Maintenance Agreement Required: ☑ Yes ☐ No

Gravel Depth 24" SAND ☐ Slab ☑ Crawl Space ☐ Basement w/plumbing ☐ Basement wo/plumbing

☑ House/Mod. Home No. Bedrooms 3

☐ Mobile Home No. Bathrooms

☐ Business No. Employees


☐ Other

Water Suppl ☐ Individual ☑ Public ☐ Commun


Comments/Conditions: ① INSTALL TOTAL OF 45 PANELS ② RAKE & LIME TRENCH WALLS ③ SYSTEM WILL REQUIRE MAINTENANCE AGREEMENT ④ PUMP TANK WILL REQUIRE IN-LINE FILTER (SIM-TECH) ⑤ MAINTAIN SETBACKS ⑥ CALL FOR SYSTEM SPECS / MANUAL DISCONNECT

Comments/Conditions: SEPTIC TANK, PUMP TANK, & DRAIN FIELD INSPECTED O.K. 5-5-05 PRESSURE CHECK O.K. 5.5-05 WATER LINE MOVED 5-6-05 ; MAINT CONTRACT 7-19-05

INITIAL SITE SKETCH SCALE 1" = 40'

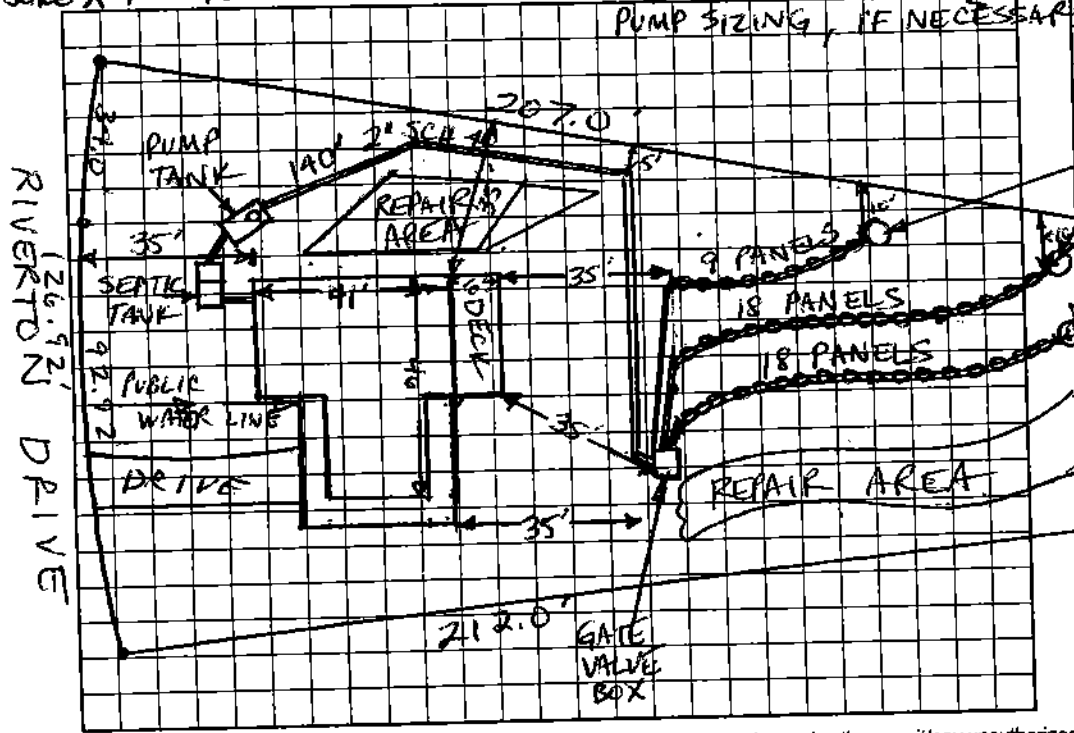

AS BUILT SKETCH 7-19-05

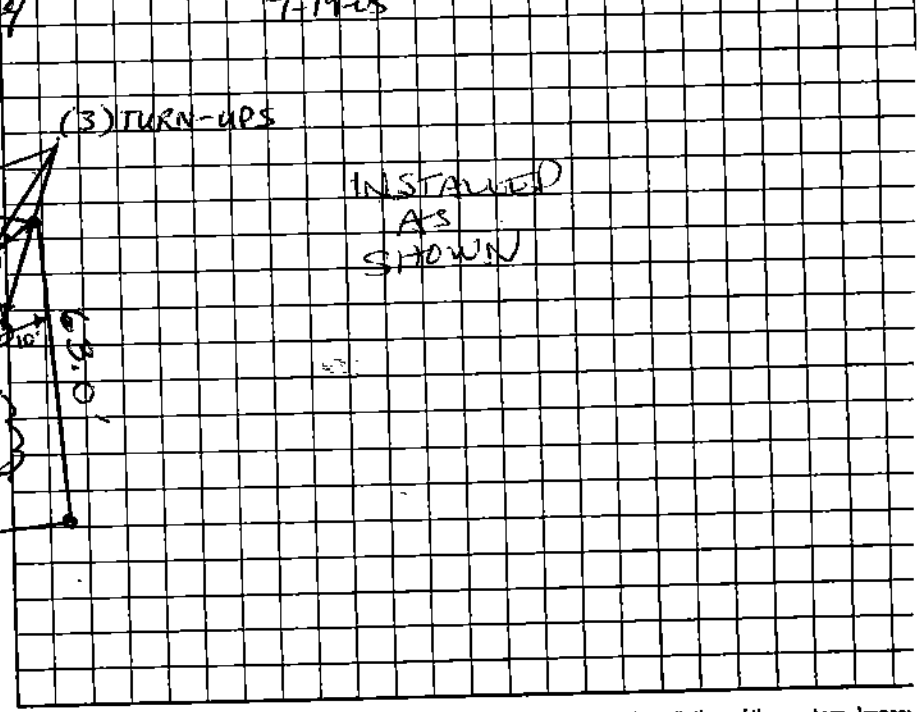

Permit can be suspended or revoked if any false information is supplied toward securing the permit/any unauthorized changes are made to the site/any unauthorized changes are made in the installation of the system. Improv

Permit with plat valid without expiration. Improvement Permit with site plan valid for sixty months. Authorization to Construct is valid for a period equal to that of Improvement Permit – not to exceed sixty months.

Signed: _____ date _____ Installed by: K & K GRADING 7-21-05

Improvement Permit by: Christopher M. Shearin, LSS date 2-24-05 Operation Permit by: Christopher M. Shearin, LSS date 7-21-

Authorization to Construct by: Christopher M. Shearin, LSS date 2-24-05 Existing System Inspection by: _____ date _____

HEALTH DEPT. COPY: WHITE OWNER COPY (FINAL): YELLOW OWNER COPY (INITIAL): PINK