IREDELL COUNTY HEALTH DEPARTMENT

STATESVILLE 704-878-5305 (E) MOORESVILLE 704-664-5281

IMPROVEMENT PERMIT / AUTHORIZATION TO CONSTRUCT / OPERATION PERMIT / EXISTING SYSTEM INSPECTION

PERMIT# 113083 PIN# 4765-36-9128 DATE 7-12-03

OWNER OR CONTRACTOR NYSTROM PROPERTIES PHONE: Business 704-400-2996 Home

ADDRESS 10816 WASHAN POTTS CORNELIUS, NC 28031

LOCATION 64 EAST, (L) RIVERHILL (L) RIVERTON, 2ND LOT ON RT IS LOT # 9

SUBDIVISION WEXFORD BLOCK / SECTION LOT 9 LOT AREA 0.459 AC SITE CLASS. PS DESIGN FLOW 360 L.T.A.R. .3

Septic Tank: 1000 Gallons; STB 825 Date 11-20-03

Pump Tank: Gallons; PT Date

Pump Make: Model Serial No.

Nitrification Field: No Fields 1 Square Feet EQ=1200' Linear Feet 300'

No Lines 3x100' Trench Width 36" Max Trench Bottom Depth 36" Gravel Depth N/A

(X) New System ☐ Repair System Type: I, II, (III), IV, V, VI

System Description: GRAV 25% REDUCT

Repair System Description: LP PANEL

Maintenance Agreement Required: ☐ Yes (X) No

(X) House/Mod. Home No. Bedrooms 3

☐ Mobile Home No. Bathrooms 2.5

☐ Business No. Employees

☐ Other


☐ Slab (X) Crawl Space ☐ Basement w/plumbing ☐ Basement wo/plumbing

Water Supply: ☐ Individual (X) Public ☐ Community

Comments:/Conditions: (1) INSTALL LINES ON CONTOURS (2) MAINTAIN SETBACKS (3) HOUSE & SYSTEM IS FLAGGED OUT COMPLETELY.

Comments:/Conditions: SEPTIC TANK WITH MARKER INSTALLED USING "POLYLOK" FILTER

INITIAL SITE SKETCH 1" ≈ 50'

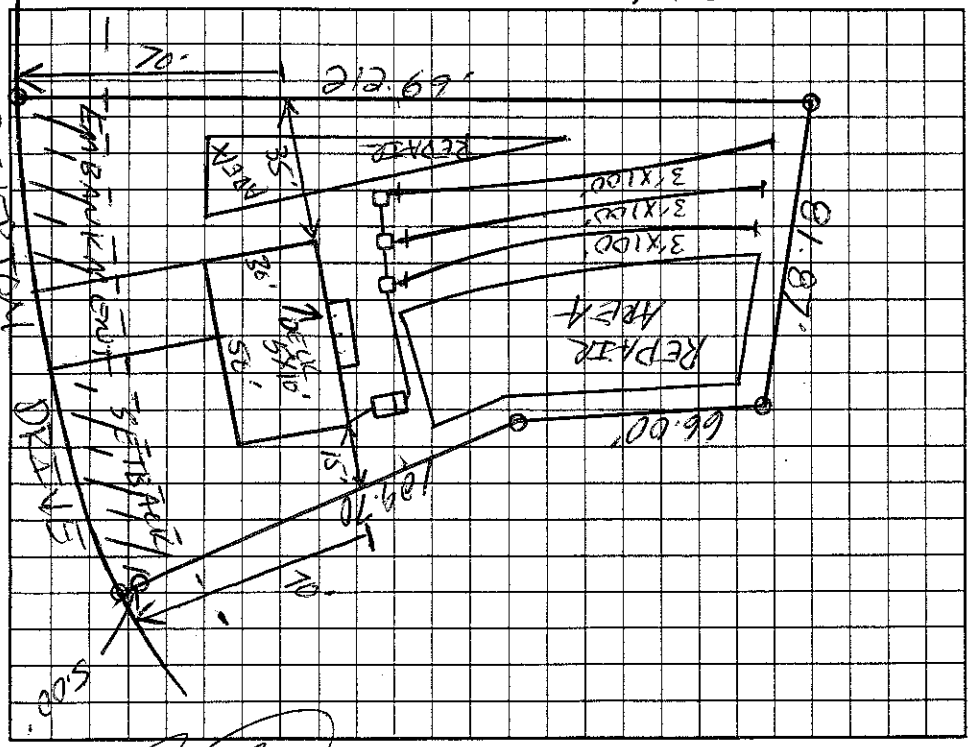

AS BUILT SKETCH

SYSTEM INSTALLED ACCORDING TO INITIAL SITE SKETCH

Permit can be suspended or revoked if any false information is supplied toward securing the permit/any unauthorized changes are made to the site/any unauthorized changes are made in the installation of the system. Improvement Permit with plat valid without expiration. Improvement Permit with site plan valid for sixty months. Authorization to Construct is valid for a period equal to that of Improvement Permit – not to exceed sixty months.

Signed: date 7/10/03 Installed by: ROWAN SEPTIC TANK

Improvement Permit by: date 7-12-03 Operation Permit by: STEVE HENDRICK date 1-16-04

Authorization to Construct by: date 7-12-03 Existing System Inspection by: date

HEALTH DEPT. COPY: WHITE OWNER COPY (FINAL): YELLOW OWNER COPY (INITIAL): PINK