IREDELL COUNTY HEALTH DEPARTMENT

STATESVILLE 704-878-5305 MOORESVILLE 704-664-5281

IMPROVEMENT PERMIT / AUTHORIZATION TO CONSTRUCT / OPERATION PERMIT / EXISTING SYSTEM INSPECTION

PERMIT# REPAIR PIN# 4765-37-7120 DATE 5-12-05

OWNER OR CONTRACTOR CHARLES THREATTE PHONE: Business (704) 657-0376 Home (704) 878-9433

ADDRESS 136 PARTRIDGE HILL LANE STATESVILLE NC 28625

LOCATION US 21 N TR JANE SOWERS TL OLD MOCKSVILLE TR CHESTNUT GROVE TR RIVER HILL TR PARTRIDGE HILL OR RT

SUBDIVISION Quail Ridge BLOCK / SECTION I LOT I LOT AREA — SITE CLASS PS DESIGN FLOW 360 L.T.A.R. —

Septic Tank: EXIST Gallons; STB ____ Date ____

Pump Tank: ____ Gallons; PT ____ Date ____

Pump Make: ____ Model ____ Serial No. ____

Nitrification Field: No Fields 1 Square Feet — Linear Feet 80

No Lines 3 Trench Width 36" Max Trench Bottom Depth 36" Gravel Depth 24"

☐ New System ☑ Repair System Type: I (II) III, IV, V, VI

System Description: ____

Repair System Description: CONVENTIONAL GRAVITY

Maintenance Agreement Required: ☐ Yes ☑ No

☑ House/Mod. Home No. Bedrooms 3

☐ Mobile Home No. Bathrooms ____

☐ Business No. Employees ____

☐ Other ____


☐ Slab ☑ Crawl Space ☐ Basement w/plumbing ☐ Basement wo/plumbing

Water Supply: ☐ Individual ☑ Public ☐ Community

Comments/Conditions: ① INSTALL SYSTEM AS SHOWN, OR DEEP ENOUGH ~~SEA~~ SO BLEEDING WON'T OCCUR ② PACK DOWN @EXISTING WATER LINE AND RELOCATE IF INTERSECTS OR IS CLOSER THAN 10' TO SYSTEM ③ USE DROP BOX ON EXISTING LINE AT END TO OFFER RELIEF TO SYSTEM BACK-UP.

Comments/Conditions: ① #5 STONE ② FILTER INSTALLED IN TANK

INITIAL SITE SKETCH

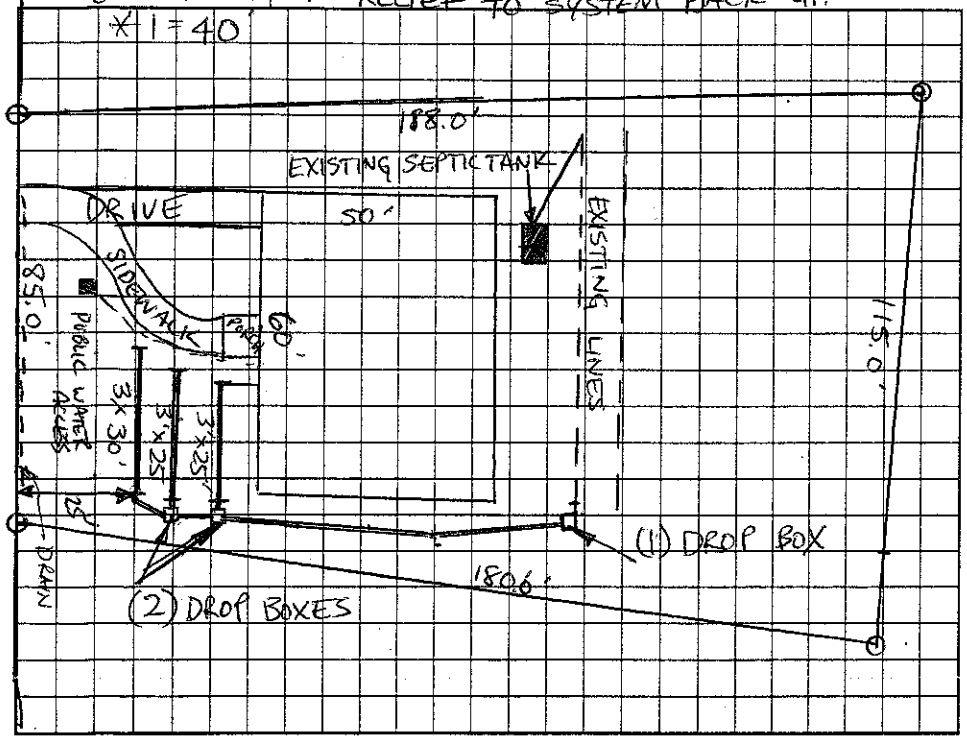

AS BUILT SKETCH

SYSTEM INSTALLED ACCORDING TO INITIAL SITE SKETCH

PARTRIDGE HILL LANE

Permit can be suspended or revoked if any false information is supplied toward securing the permit/any unauthorized changes are made to the site/any unauthorized changes are made in the installation of the system. Improvement Permit with plat valid without expiration. Improvement Permit with site plan valid for sixty months. Authorization to Construct is valid for a period equal to that of Improvement Permit – not to exceed sixty months.

Signed: [signature] date 5-19-05 Installed by: JAMES HUDLER

Improvement Permit by: Christopher M. Sherrill, RS, LSS date 5-12-05 Operation Permit by: Christopher M. Sherrill RS LSS date 7-22-05

Authorization to Construct by: Christopher M. Sherrill RS, LSS date 5-12-05 Existing System Inspection by: ____ date ____

HEALTH DEPT. COPY: WHITE OWNER COPY (FINAL): YELLOW OWNER COPY (INITIAL): PINK