IREDELL COUNTY HEALTH DEPARTMENT

STATESVILLE 704-878-5305 MOORESVILLE 704-664-5281

IMPROVEMENT PERMIT / AUTHORIZATION TO CONSTRUCT / OPERATION PERMIT / EXISTING SYSTEM INSPECTION

PERMIT# FR8033 PIN# 4765386591 DATE 12-4-98

OWNER OR CONTRACTOR John moore PHONE: Business 873 9612 Home

ADDRESS Po Box 1283 Sta N.C.

LOCATION 64E TL Riverhill Rd TL Partridge Hill TR Sparrow TL

SUBDIVISION Quail Ridge BLOCK / SECTION LOT 59 LOT AREA 1.6 acres SITE CLASS. PS DESIGN FLOW 360 L.T.A.R. .33

Septic Tank: 1000 Gallons; STB 794 Date 2-28-94
Pump Tank: Gallons; PT Date
Pump Make: Model Serial No.
Nitrification Field: No Fields 1 Square Feet 1080 Linear Feet 360
No Lines 6 Trench Width 36" Max Trench Bottom Depth 36" Gravel Depth 12"

[X] New System [ ] Repair System Type: I, II, III, IV, V, VI
System Description: Conv. Gravity
Repair System Description:
Maintenance Agreement Required: [ ] Yes [ ] No


[X] House/Mod. Home No. Bedrooms 3
[ ] Mobile Home No. Bathrooms 2
[ ] Business No. Employees
[ ] Other
[ ] Slab [X] Crawl Space [ ] Basement w/plumbing [ ] Basement wo/plumbing

Water Supply: [ ] Individual [X] Public [ ] Community


Comments:/Conditions:

Comments:/Conditions:

INITIAL SITE SKETCH

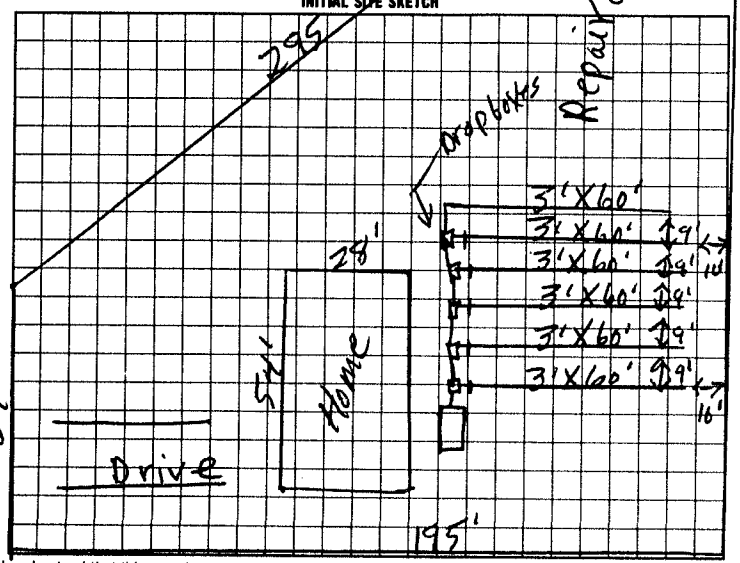

AS BUILT SKETCH

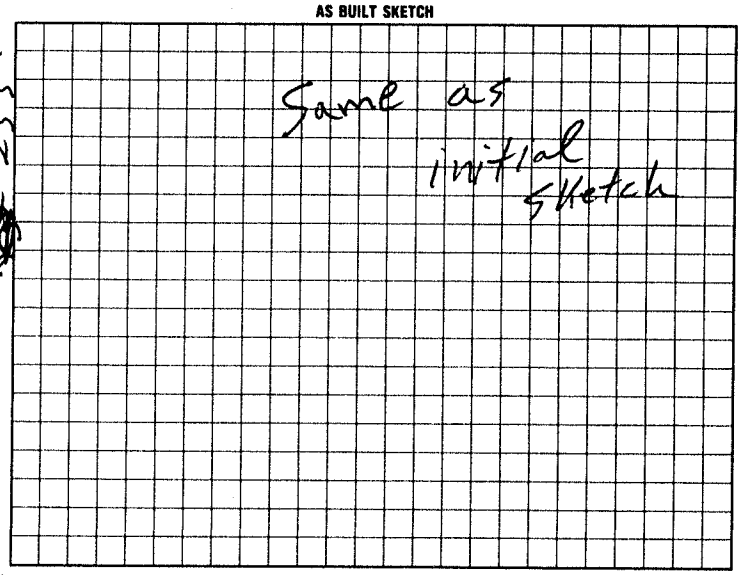

I understand that this permit can be suspended or revoked if any false information is supplied toward securing the permit/any unauthorized changes are made to the site/any unauthorized changes are made in the installation of the system. Improvement Permit with plat valid without expiration. Improvement Permit with site plan valid for sixty months. Authorization to Construct is valid for a period equal to that of Improvement Permit – not to exceed sixty months.

Signed: Kenneth M. [illegible] date 12/15/98 Installed by: Tuckers Hauling Grading

Improvement Permit by: R. C. moore date 12-4-98 Operation Permit by: R. C. moore date 4-9-99

Authorization to Construct by: R. C. moore date 12-4-98 Existing System Inspection by: date

HEALTH DEPT. COPY: WHITE INSPECTION COPY (FINAL): GREEN OWNER COPY (FINAL): YELLOW INSPECTION COPY (INITIAL): PINK OWNER COPY (INITIAL): GOLD