IREDELL COUNTY HEALTH DEPARTMENT

Statesville Office (704) 878-5305 Mooresville Office (704) 660-3625 PERMIT # 204584

IMPROVEMENT PERMIT / AUTHORIZATION TO CONSTRUCT / OPERATION PERMIT / EXISTING SYSTEM

PIN # 4765319068

APPLICANT: Hayday Investments LLC APPLICANT ADDRESS: 161 West Davson Mill Rd.

SITE ADDRESS: 132 Carter Ln. Rd. PHONE: 704-873-2547 ALT. PHONE: N/A

SITE DIRECTIONS: Hwy 64E TR Bell Farm Rd TR Carter Ln. Property on Right


SUBDIVISION: Carter Meadows SECTION: N/A LOT # 4 LOT AREA: 1.59 acres DESIGN FLOW: 360 gpd L.T.A.R.: 0.25

Septic Tank	1000 (gal)	STB	760	Date	8-21-14	☑ New System	☐ Repair	☐ Expansion	System Type: I II III IV V VI	☑ Residence	No. Bedrooms 3
Pump Tank	1000 (gal)	PT	363	Date	5-13-14	System Description:	25% Reduction			☐ Business	No. Persons 6
Pump Make	Zoeller	Model	BN 151	Serial #	151-0005	Repair System Description:	Low Pressure PPBPS			☐ Other	No. Employees
# Nitrification Fields	1	# Lines	3	Linear Ft:	360	Maintenance Agreement Required:	☐ YES	☑ NO		☐ Slab	☑ Crawl Space
Trench Width	36"	Max. Trench Bottom Depth	36"	Gravel Depth	N/A		☐ GRAVITY	☑ PRESSURE		☐ Basement w/plumbing	☐ Basement w/o plumbing

Water Supply: ☐ Private ☑ Public ☐ Community

Comments / Conditions: IMPROVEMENTS ONLY: Submit Floor plan & written statement from Utility Company providing approval to encroach on overhead utilities easement, prior to issuance of CA's Install a 25% Reduction system on contour with parallel distribution utilizing a pressure manifold. ★ DO NOT CUT FOR HOUSE SITE ★

INITIAL SITE SKETCH

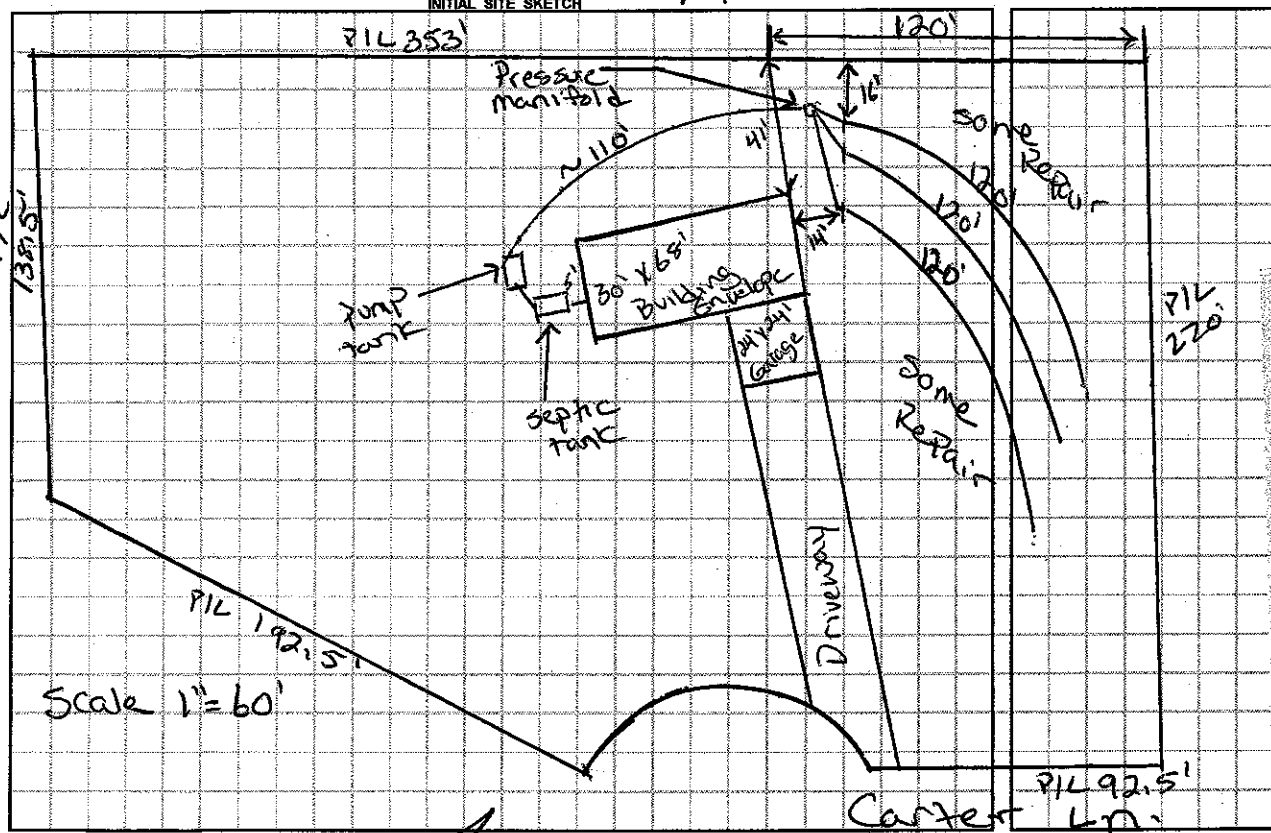

AS BUILT SKETCH

	Date	Initials
Drain Lines Checked	01/22/15	HS
Tanks Checked	01/22/15	HS
Pressure Manifold or Valve Box Checked	01/22/15	HS
Pressure Head Set	01/22/15	HS
Electrical Checked	02/09/15	HS
Floats Set	01/22/15	HS
Alarm Checked	02/09/15	HS
Maintenance Contract Y / N	N/A	

Permit can be suspended or revoked if any false information is supplied toward securing the permit / any unauthorized changes are made to the site / any unauthorized changes are made in the installation of the system. **CONTACT A LOCATOR SERVICE PRIOR TO ANY EXCAVATION**

☐ **IMPROVEMENT PERMIT** *with plat valid without expiration.* ☑ **IMPROVEMENT PERMIT** *with site plan valid for 60 mos.* ☑ **AUTHORIZATION TO CONSTRUCT** *valid for period equal to IMPROVEMENT PERMIT--not to exceed 60 mo.*

Owner / Applicant Signature: [signature] Date: 11-25-14 Installed by: Abee's Grading

IMPROVEMENT PERMIT by: Justin Henderson Date: 11-4-14 OPERATION PERMIT by: [signature] Date: 02/10/15

AUTHORIZATION TO CONSTRUCT by: Justin Henderson Date: 11-12-14 Existing System Inspected by: Date:

Health Dept. Copy - WHITE Applicant (Final Approval) - YELLOW Applicant (Conditional Approval) - PINK