IREDELL COUNTY HEALTH DEPARTMENT

Statesville Office (704) 878-5305 Mooresville Office (704) 660-3625 PERMIT # 176752

IMPROVEMENT PERMIT / AUTHORIZATION TO CONSTRUCT / OPERATION PERMIT / EXISTING SYSTEM

PIN # 4765410853

APPLICANT: Joe Nicholson APPLICANT ADDRESS: 135 Chantilly Ln

SITE ADDRESS: 135 Chantilly Ln PHONE: 704-397-7273 ALT. PHONE: N/A


SITE DIRECTIONS: Hwy 64 E TR Bell Farm Rd. TR Chantilly Ln, SD LOT on LEFT

SUBDIVISION: Hidden Valley MHP SECTION: N/A LOT # 23 LOT AREA: 0.51 acres DESIGN FLOW: 360 gpd L.T.A.R.: Existing

Septic Tank	Existing (gal)	STB	Date	☐ New System ☐ Repair ☐ Expansion	System Type: I ☒ II III IV V VI	☑ Residence	No. Bedrooms	3	Water Supply
Pump Tank	(gal)	PT	Date	System Description:	Conventional	☐ Business	No. Persons		☐ Private
Pump Make	Model		Serial #	Repair System Description:		☐ Other	No. Employees		☑ Public
# Nitrification Fields	Ex # Lines Ex		Linear Ft: Ex	Maintenance Agreement Required:	☐ YES ☒ NO	☐ Slab	☑ Crawl Space		☐ Community
Trench Width	Ex Max. Trench Bottom Depth Ex			Gravel Depth Ex	☑ GRAVITY ☐ PRESSURE	☐ Basement w/plumbing			☐ Basement w/o plumbing

Comments / Conditions: - Maintain a minimum of 5' between home foundation & all components of septic tank system.

INITIAL SITE SKETCH

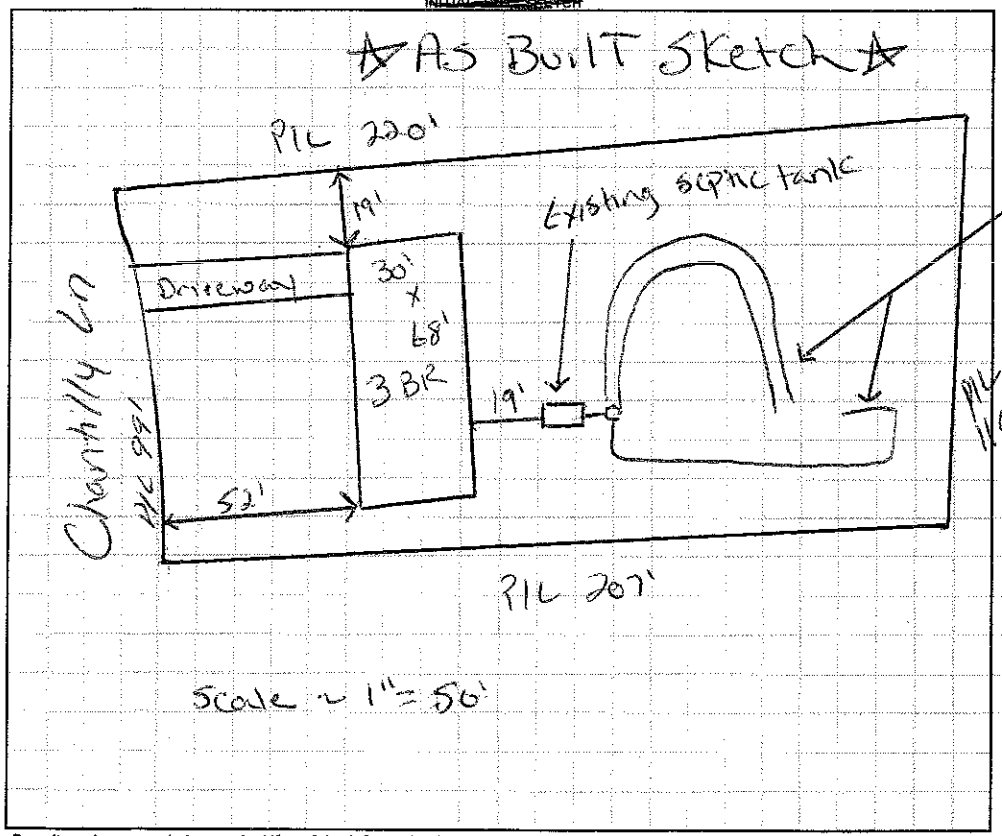

AS BUILT SKETCH

Permit can be suspended or revoked if any false information is supplied toward securing the permit / any unauthorized changes are made to the site / any unauthorized changes are made in the installation of the system. **CONTACT A LOCATOR SERVICE PRIOR TO ANY EXCAVATION**

☐ **IMPROVEMENT PERMIT** *with plat valid without expiration.* ☐ **IMPROVEMENT PERMIT** *with site plan valid for 60 mos.* ☐ **AUTHORIZATION TO CONSTRUCT** *valid for period equal to IMPROVEMENT PERMIT--not to exceed 60 mo.*

Owner / Applicant Signature: Joe Nicholson Date: Installed by:

IMPROVEMENT PERMIT by: Date: OPERATION PERMIT by: Date:

AUTHORIZATION TO CONSTRUCT by: Date: Existing System Inspected by: Justin Henderson Date: 2-13-13

Health Dept. Copy - WHITE Applicant (Final Approval) - YELLOW Applicant (Conditional Approval) - PINK