IREDELL COUNTY HEALTH DEPARTMENT - *ENVIRONMENTAL HEALTH* ☐ STATESVILLE OFFICE 704-878-5305 ☐ MOORESVILLE OFFICE 704-664-5281

IMPROVEMENT PERMIT / AUTHORIZATION TO CONSTRUCT / OPERATION PERMIT / EXISTING SYSTEM INSPECTION

PERMIT # Repair PIN # 4765-41-2885 DATE 17 August 2011

OWNER Latonia Graham APPLICANT: PHONE: Home/Cell # (704) 464-6256 Business #

SITE ADDRESS 121 Chantilly Ln Statesville OWNER / APPLICANT ADDRESS

SITE DIRECTIONS I-77 to E TR Bell Farm TR Chantilly on Left.

SUBDIVISION Hidden Valley BLOCK / SECTION LOT # 25 LOT AREA 1.02 ac. DESIGN FLOW 360 g/d L.T.A.R. Exist.

Septic Tank 1000 Gallons: STB Date

Pump Tank Gallons: P T Date

Pump Make Model Serial #

No. Nitrification Fields: Ex No. Lines Ex Linear Feet Ex

Trench Width Ex Max. Trench Bottom Depth Ex Gravel Depth

☐ New System ☑ Repair ☐ Expansion System Type I (II) III IV V VI

System Description: Conventional gravity

Repair System Description: Tank

Maintenance Agreement Required ☐ YES ☑ NO

☑ GRAVITY ☐ PRESSURE

☑ Residence No. Bedrooms 3

☐ Business No. Persons

☐ Other No. Employees

☐ Slab ☑ Crawl Space

☐ Basement w/plumbing ☐ Basement w/o plumbing


Water Supply: ☐ Private ☑ Public ☐ Community

Comments / Conditions

Replace Existing Septic tank with a new 1000g ST. Properly abandon exist. septic tanks.

Pump lock Filter.

INITIAL SITE SKETCH

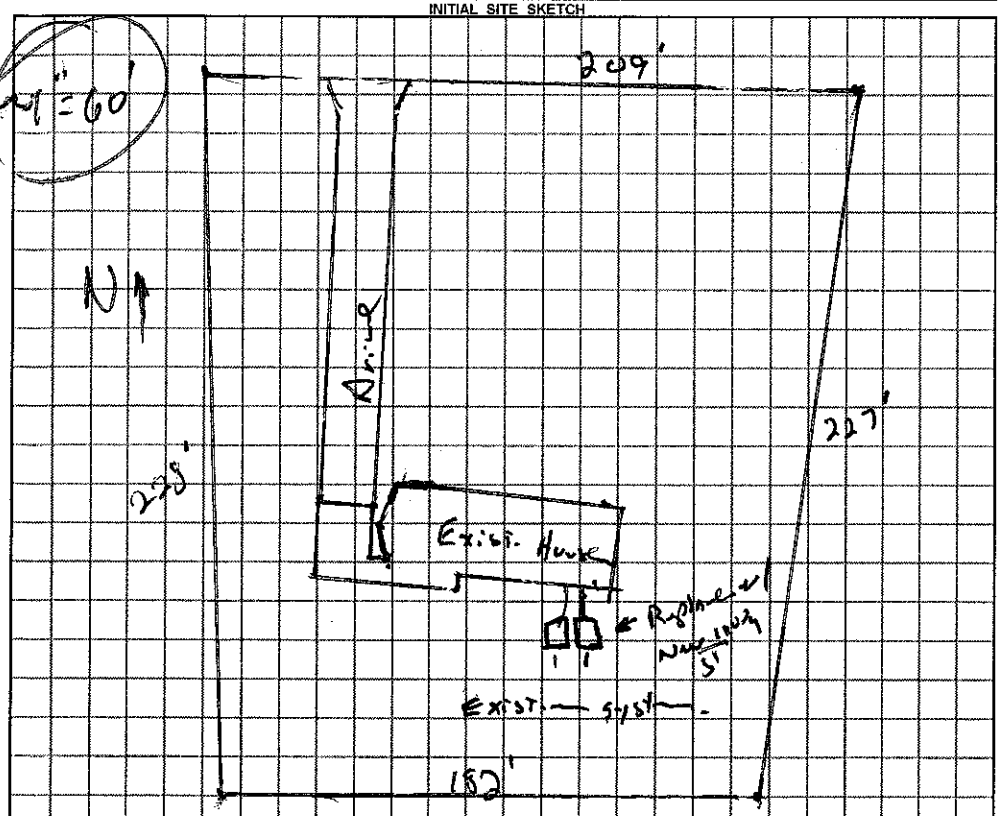

AS BUILT SKETCH

Installed As Drawn

Permit can be suspended or revoked if any false information is supplied towards securing the permit / any unauthorized changes are made to the site / any unauthorized changes are made in the installation of the system.

☐ *IMPROVEMENT PERMIT* with plat valid without expiration. ☑ *IMPROVEMENT PERMIT* with plat valid without expiration. site plan valid 60 mo. ☑ *AUTHORIZATION TO CONSTRUCT* valid for period equal to IMPROVEMENT PERMIT--not to exceed 60 mo.

Owner / Applicant Signature: Latonia Graham Date 8-18-11 Installed by: A-1 Backhoe

IMPROVEMENT PERMIT by: REHS Date

AUTHORIZATION TO CONSTRUCT by: REHS Date 17 August 11

OPERATION PERMIT by: REHS Date 18 Aug. 11

Existing System Inspected by: REHS Date

YOU SHOULD CONTACT A LOCATOR SERVICE PRIOR TO ANY EXCAVATION

White Copy – Environmental Health YELLOW COPY (Final) Owner / Applicant PINK COPY (Initial) Owner / Applicant