IREDELL COUNTY HEALTH DEPARTMENT

Statesville Phone TR 3-7271 Mooresville Phone No. 664-5281

PERMIT TO INSTALL SEPTIC TANK

Permit No. 271 Permit Date 6 Apr 1973

Owner Builder Mike Beaucar Address Statesville, N.C

Installed By Mike Beaucar Address Statesville, N.C

Location of Property Right off 64 E on Bell Rd.


½ mile on Right

Tank		Capacity		Length of Lines		Fixtures	
Block	( )	1000	(✓)	225'	(✓)	No. of Baths	(2)
Precast	(✓)	1250	( )	250'	( )	Dishwasher	( )
		1500	( )	Other		Garbage Grdr.	( )
		Other				Other	

NOTIFY HEALTH DEPARTMENT AT LEAST EIGHT HOURS BEFORE TANK IS TO BE INSPECTED.

Final Inspection 6 Apr 1973 Approved (✓) Disapproved ( )

Remarks Iredell Water

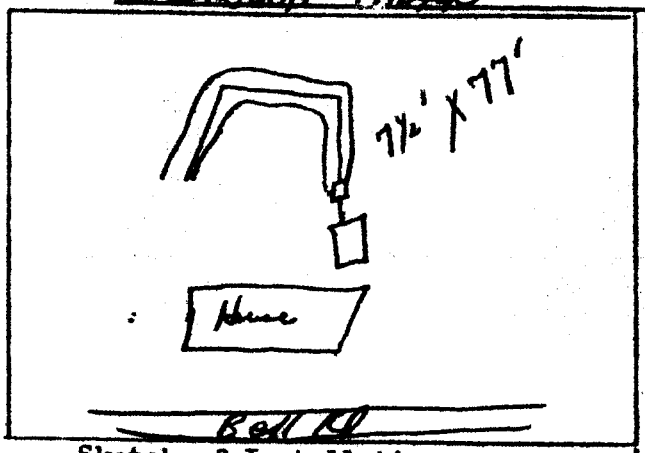

Sketch of Installation

Mike Howard

Sanitarian