IREDELL COUNTY HEALTH DEPARTMENT

Statesville Office (704) 878-5305 Mooresville Office (704) 660-3625 PERMIT # 176788

IMPROVEMENT PERMIT / AUTHORIZATION TO CONSTRUCT / OPERATION PERMIT / EXISTING SYSTEM

PIN # 4765418241

APPLICANT: Carroll Lechbetter APPLICANT ADDRESS: 207 Bell Farm Rd.

SITE ADDRESS: 207 Bell Farm Rd. PHONE: 704-872-5409 ALT. PHONE: 704-872-6686

SITE DIRECTIONS: Hwy 64 E TR Bell Farm Rd.


SUBDIVISION: N/A SECTION: N/A LOT # N/A LOT AREA: 0.65 acres DESIGN FLOW: 360gpd. L.T.A.R.: 0.2

Septic Tank	Existing (gal)	STB	Date	☐ New System	☑ Repair	☐ Expansion	System Type: I II III IV V VI	☑ Residence	No. Bedrooms 3
Pump Tank	(gal)	PT	Date	System Description:				☐ Business	No. Persons
Pump Make	Model		Serial #	Repair System Description: Existing drainfield 125% Red.				☐ Other	No. Employees
# Nitrification Fields 1	# Lines 1		Linear Ft: 64	Maintenance Agreement Required:	☐ YES	☑ NO		☐ Slab	☑ Crawl Space
Trench Width 36"	Max. Trench Bottom Depth AS SHALLOW AS POSSIBLE		Gravel Depth N/A		☑ GRAVITY	☐ PRESSURE		☐ Basement w/plumbing	☐ Basement w/o plumbing

Water Supply: ☐ Private ☑ Public ☐ Community

Comments / Conditions: - Set New Distribution box as shallow as possible. Set to feed existing drainfield first.; Locate all utilities; Install New 25% Reduction line as flagged/drawn as shallow as possible, maintaining a minimum 6" Covers. Grade yard to a uniform slope over existing drainfield area to shed water. Place speed leveler in distribution box set to feed new line last.

INITIAL SITE SKETCH

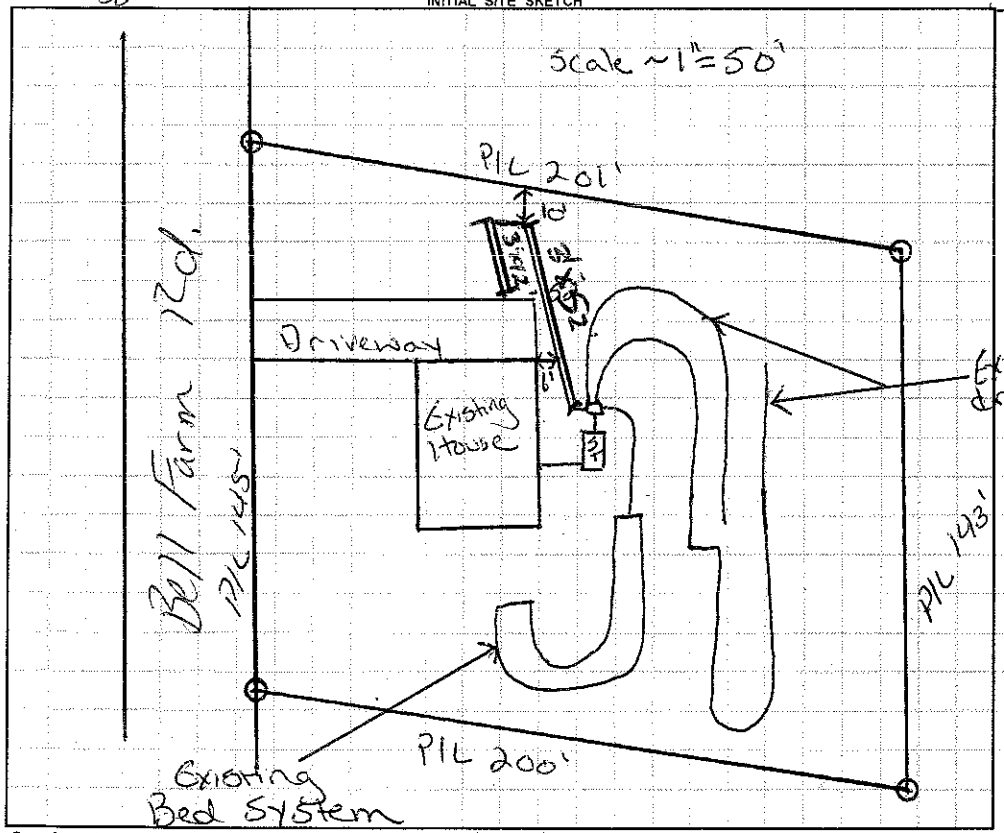

AS BUILT SKETCH

- Quick 4 Chamber installed
- Red Poly lok filter installed
- Installed as drawn

Permit can be suspended or revoked if any false information is supplied toward securing the permit / any unauthorized changes are made to the site / any unauthorized changes are made in the installation of the system. **CONTACT A LOCATOR SERVICE PRIOR TO ANY EXCAVATION**

☐ **IMPROVEMENT PERMIT** *with plat valid without expiration.* ☑ **IMPROVEMENT PERMIT** *with site plan valid for 60 mos.* ☑ **AUTHORIZATION TO CONSTRUCT** *valid for period equal to IMPROVEMENT PERMIT--not to exceed 60 mo.*

Owner / Applicant Signature: Brian Lechbetter Date: 2-5-13 Installed by: Lentz Septic

IMPROVEMENT PERMIT by: Justin Henderson Date: 2-4-13 OPERATION PERMIT by: Justin Henderson Date: 3-7-13

AUTHORIZATION TO CONSTRUCT by: Justin Henderson Date: 2-4-13 Existing System Inspected by: Date:

Health Dept. Copy - WHITE Applicant (Final Approval) - YELLOW Applicant (Conditional Approval) - PINK