IREDELL COUNTY HEALTH DEPARTMENT

STATESVILLE 704-878-5305 MOORESVILLE 704-664-5281

47245

IMPROVEMENT PERMIT / CERTIFICATE OF COMPLETION / OPERATION PERMIT / EXISTING SYSTEM INSPECTION

PROPERTY DESCRIPTION NO. 16343 DATE 6-4-93 TAX MAP NO. 55-A-8 21

OWNER OR CONTRACTOR Robert Bourbeau PHONE: Business Statesville Home 873-3954

ADDRESS 3538 Cambridge Place

LOCATION NS 64 E TR Vance Pd #2 across from Riverhill Rd 1st house on left

SUBDIVISION BLOCK / SECTION LOT 3/4 LOT AREA 3/4 acre SITE CLASS PS L.T.A.R. .4

1500

Water Supply: ☐ Individual ☐ Community ☑ Public

Septic Tank: 1250 Gallons; STB 1011 Date 4-4-93

Pump Tank: Gallons; PT Date

Nitrification Field: No Fields 1 Square Feet 900 Linear Feet 300

No Lines 4 Trench Width 36 Trench Depth 24 Gravel Depth 12

☐ New System ☑ Repair System Type: I. II. IV. V. VI

System Description: Conv. Gravity

Repair System Description:

Maintenance Agreement Required: ☐ Yes ☑ No

☑ House/Mod. Home ☐ Mobile Home ☐ Business ☐ Other

No. Bedrooms 3 No. Bathrooms 2 No. Employees

☐ Slab ☑ Crawl Space ☐ Basement w/plumbing ☐ Basement wo/plumbing

Garbage Disposal: ☑ Yes ☐ No

Auto. Dishwasher: ☑ Yes ☐ No


Auto. Washing Machine: ☐ Yes ☐ No

Other

Comments Replacing old system to take care of addition to existing house

Fill in old Septic Tank with Compacted soil

INITIAL SITE SKETCH

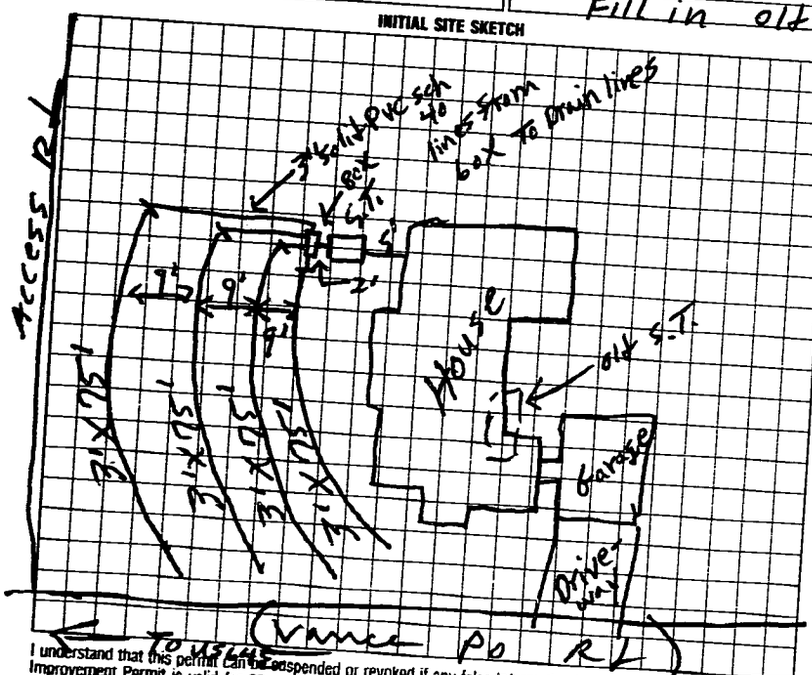

AS BUILT SKETCH

(Same)

I understand that this permit can be suspended or revoked if any false information is supplied toward securing the permit/any unauthorized changes are made to the site/any unauthorized changes are made in the installation of the system. Improvement Permit is valid for 60 months from date of issuance.

Signed:

Improvement Permit by: P.C. moore date 6-8-93

Existing System Inspection by: date

Installed by: AAA Enterprizes Barry Sisman

Certificate of Completion by: P.C. moore date 6-24-93

Operation Permit by: date

HEALTH DEPT. COPY: WHITE INSPECTION COPY (FINAL): GREEN OWNER COPY (FINAL): YELLOW INSPECTION COPY (INITIAL): PINK OWNER COPY (INITIAL): GOLD