IREDELL COUNTY HEALTH DEPARTMENT

Statesville Phone TR 3-7271 Mooresville Phone No. 664-5281

PERMIT TO INSTALL SEPTIC TANK

Permit No. 0 Permit Date 10-17 1973

Owner MIKE BRANNON Address STATESVILLE

Installed By HENRY SIGMON Address STATESVILLE


Location of Property 64 E - RIGHT ON BELL RD. - Rt 1ST PAVED Rd. (HIDDEN VALLEY) 2ND House ON Rt.

Tank		Capacity		Length of Lines		Fixtures	
Block	( )	1000	( )	225'	( )	No. of Baths	( )
Precast	( )	1250	( )	250'	( )	Dishwasher	( )
	REPAIR	1500	( )	Other 225		Garbage Grdr.	( )
		Other				Other	

NOTIFY HEALTH DEPARTMENT AT LEAST EIGHT HOURS BEFORE TANK IS TO BE INSPECTED.

Final Inspection ____ 19__ Approved (✓) Disapproved ( )

Remarks

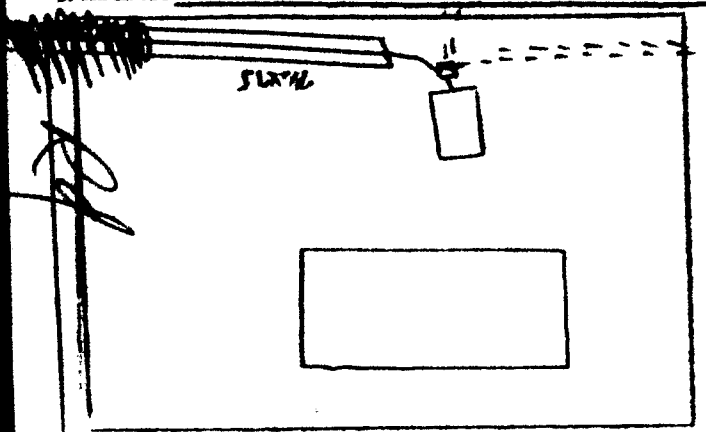

Sketch of Installation

Glenn Fox Jr.

Sanitarian