IREDELL COUNTY HEALTH DEPARTMENT

Statesville Office (704) 878-5305 Mooresville Office (704) 660-3625 PERMIT # 224603

IMPROVEMENT PERMIT / AUTHORIZATION TO CONSTRUCT / OPERATION PERMIT / EXISTING SYSTEM

PIN # 4765-42-6009

APPLICANT: Elsie Roman APPLICANT ADDRESS: 164 Bell Farm Road Statesville 28625

SITE ADDRESS: 164 Bell Farm Rd. Statesville, NC 28625 PHONE: ALT. PHONE:


SITE DIRECTIONS: Rt 64 East from Statesville → R on Bell Farm Rd → 1000 ft ahead on Right (at turnoff w/ Chantilly Lane)

SUBDIVISION: — SECTION: — LOT # — LOT AREA: 1.00 acres DESIGN FLOW: 360 GPD L.T.A.R.: 0.275

Septic Tank	Ex 1000	(gal)	STB	Ex	Date	Ex	☐ New System ☒ Repair ☐ Expansion	System Type: I II (III) IV V VI	☒ Residence	No. Bedrooms	3	Water Supply
Pump Tank	—	(gal)	PT	—	Date	—	System Description:		☐ Business	No. Persons	6	☐ Private
Pump Make	—	Model		—	Serial #	—	Repair System Description: 25% Reduction - Undersized		☐ Other	No. Employees		☒ Public
# Nitrification Fields	1	# Lines	5		Linear Ft:	156'	Maintenance Agreement Required:	☐ YES ☒ NO	☐ Slab	☐ Crawl Space		☐ Community
Trench Width	36"	Max. Trench Bottom Depth	18"-22" Highside		Gravel Depth	—	☒ GRAVITY	☐ PRESSURE	☒ Basement w/plumbing			☐ Basement w/o plumbing

Comments / Conditions: This is an undersized septic system repair permit. You are strongly encouraged to practice conservative water use. Recommend snaking the pipes to the original system area to remove any possible blockage. Also recommend removing the above-ground pool and pumping the septic tank every 3-5 years.

INITIAL SITE SKETCH

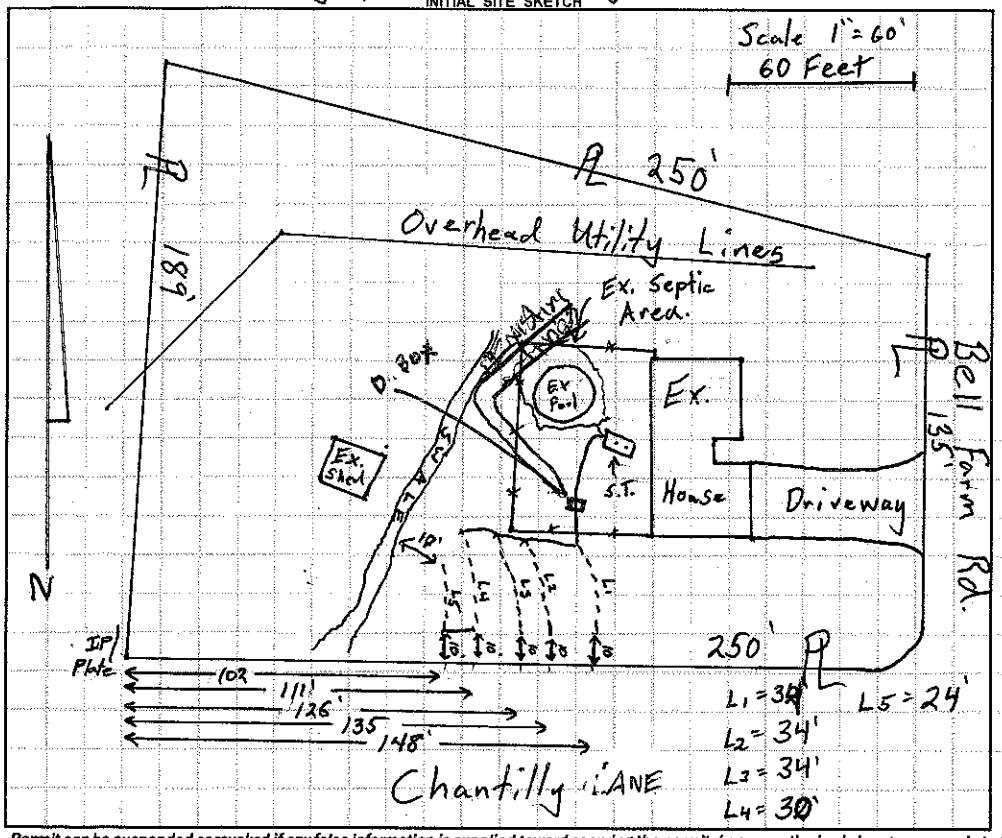

AS BUILT SKETCH

Installed Quik 4 as drawn

Permit can be suspended or revoked if any false information is supplied toward securing the permit / any unauthorized changes are made to the site / any unauthorized changes are made in the installation of the system. **CONTACT A LOCATOR SERVICE PRIOR TO ANY EXCAVATION**

☐ **IMPROVEMENT PERMIT** *with plat valid without expiration.* ☒ **IMPROVEMENT PERMIT** *with site plan valid for 60 mos.* ☒ **AUTHORIZATION TO CONSTRUCT** *valid for period equal to IMPROVEMENT PERMIT--not to exceed 60 mo.*

Owner / Applicant Signature: s/u by E. Roman emailed 3.1.17 Date: 2/28/17* Installed by: Lantz Wastewater

IMPROVEMENT PERMIT by: Thomas Church Date: 3-1-17 OPERATION PERMIT by: Date: 03/23/17

AUTHORIZATION TO CONSTRUCT by: Thomas Church Date: 3-1-17 Existing System Inspected by: Date:

Health Dept. Copy - WHITE Applicant (Final Approval) - YELLOW Applicant (Conditional Approval) - PINK