IREDELL COUNTY HEALTH DEPARTMENT - *ENVIRONMENTAL HEALTH* ☑ STATESVILLE OFFICE 704-878-5305 ☐ MOORESVILLE OFFICE 704-664-5281

IMPROVEMENT PERMIT / AUTHORIZATION TO CONSTRUCT / OPERATION PERMIT / EXISTING SYSTEM INSPECTION

PERMIT # 174619 PIN # 4765426009 DATE 9-19-12

OWNER Glsie Roman APPLICANT: Glsie Roman PHONE: Home/Cell # 704-682-4238 Business # N/A

SITE ADDRESS 164 Bell Farm Rd. OWNER / APPLICANT ADDRESS 164 Bell Farm Rd. Statesville

SITE DIRECTIONS 64 E TR Bell Farm Rd.

SUBDIVISION N/A BLOCK / SECTION N/A LOT # N/A LOT AREA .89 acres DESIGN FLOW Existing L.T.A.R. Existing

Septic Tank Existing Gallons: STB Date

Pump Tank Gallons: P T Date

Pump Make Model Serial #

No. Nitrification Fields Ex No. Lines Ex Linear Feet Ex

Trench Width Ex Max. Trench Bottom Depth Ex Gravel Depth Ex

☐ New System ☐ Repair ☐ Expansion System Type I ☐ II ☐ III ☐ IV ☐ V ☐ VI

System Description: Conventional

Repair System Description:

Maintenance Agreement Required ☐ YES ☑ NO

☐ GRAVITY ☐ PRESSURE

☑ Residence No. Bedrooms 6x

☐ Business No. Persons

☐ Other No. Employees

☐ Slab ☐ Crawl Space

☐ Basement w/plumbing ☑ Basement w/o plumbing

Water Supply


☐ Private

☑ Public


☐ Community

Comments / Conditions

INITIAL SITE SKETCH

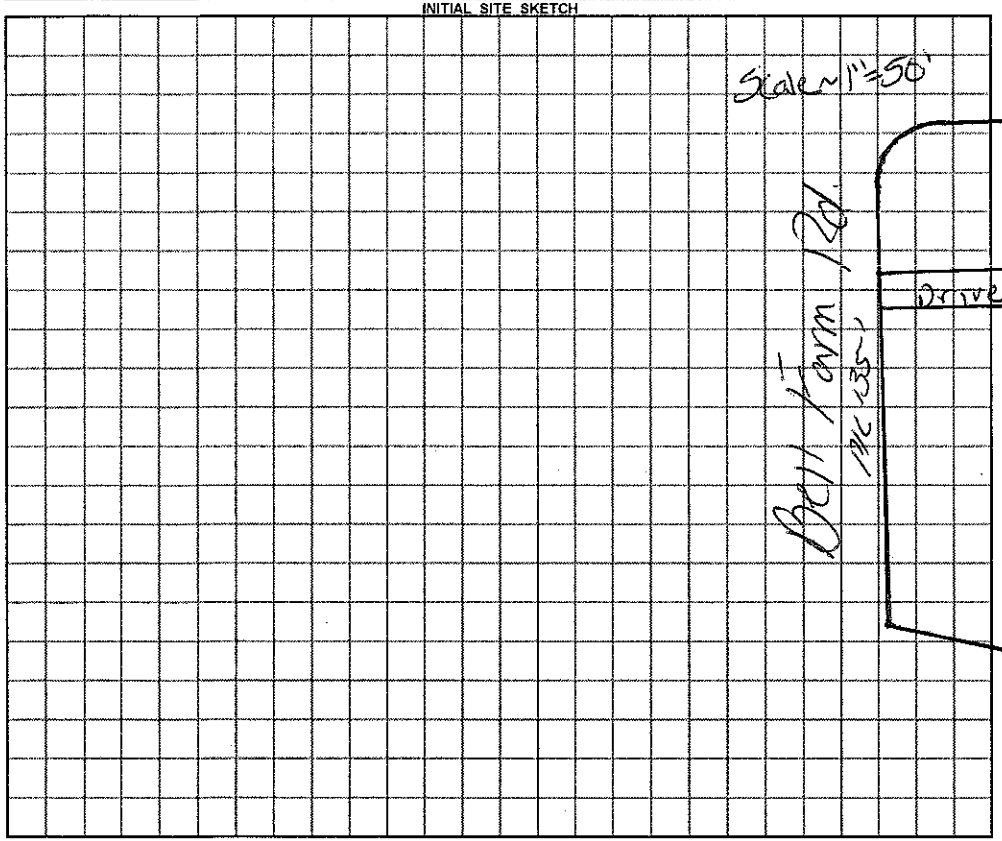

AS BUILT SKETCH

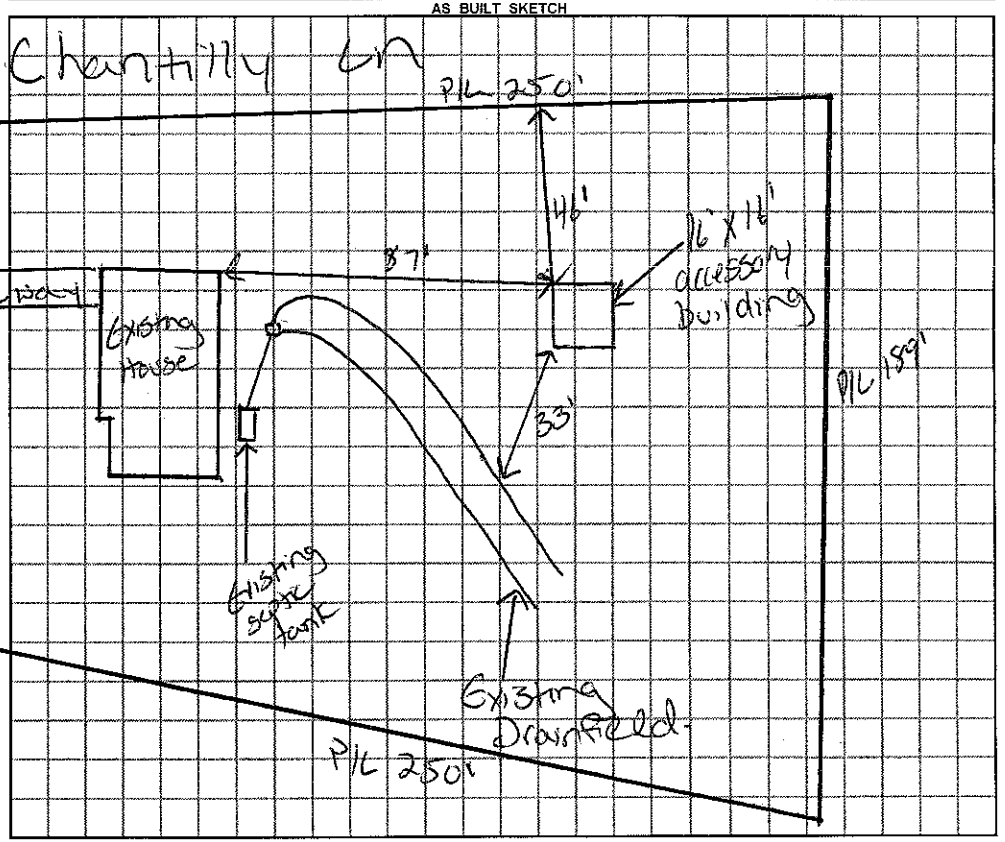

Permit can be suspended or revoked if any false information is supplied toward securing the permit / any unauthorized changes are made to the site / any unauthorized changes are made in the installation of the system.

☐ ***IMPROVEMENT PERMIT*** *with plat valid without expiration.* ☐ ***IMPROVEMENT PERMIT*** *with ~~plat valid without expiration.~~ site plan valid 60 mo.* ☐ ***AUTHORIZATION TO CONSTRUCT*** valid for period equal to IMPROVEMENT PERMIT--not to exceed 60 mo.

Owner / Applicant Signature: _____ Date _____ Installed by: _____

IMPROVEMENT PERMIT by: _____ ***REHS*** Date _____ OPERATION PERMIT by: _____ ***REHS*** Date _____

AUTHORIZATION TO CONSTRUCT by: _____ ***REHS*** Date _____ Existing System Inspected by: Justin Henderson ***REHS*** Date 9-19-12

YOU SHOULD CONTACT A LOCATOR SERVICE PRIOR TO ANY EXCAVATION

White Copy – Environmental Health YELLOW COPY (Final) Owner / Applicant PINK COPY (Initial) Owner / Applicant