IREDELL COUNTY HEALTH DEPARTMENT

Statesville Phone TR 3-7271 — Mooresville Phone NO 3-1271

PERMIT TO INSTALL SEPTIC TANK

Permit NO. _____ Permit Date MARCH 4, 1958

Owner R.A. LOWERY Address _____

Installed By CLYDE HOKE Address _____


Location of Property ON MOORESVILLE RD. - RIGHT ~~LEFT~~ AT BEAVERS BROS STORE - 1ST HOUSE ON RIGHT

Tank		Capacity		Length of Lines		Fixtures	
Block	( )	800	( )	150'	(✓)	No. of Baths	(1)
Precast	( )	900	( )	175'	( )	Dishwasher	( )
		1000	( )	200'	( )	Garbage Grdr.	( )
EXISTING		1100	( )	225'	( )	Auto-Washer	( )
		1200	( )	250'	( )	Other	_____
		Other	_____	Other	LINES ONLY		

NOTIFY HEALTH DEPARTMENT AT LEAST EIGHT HOURS BEFORE TANK IS TO BE INSPECTED.

Final Inspection MARCH 4 1958 Approved (✓) Disapproved ( )

Remarks _____

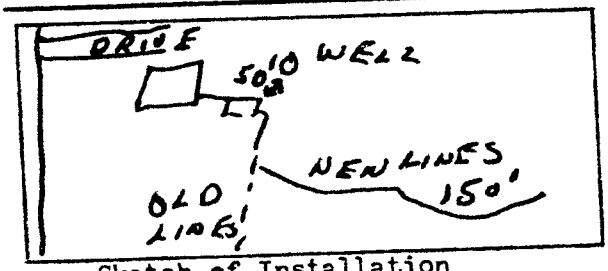

Sketch of Installation

Rayford A. Holmes
Sanitarian