DOLLAR GENERAL - US 64 EAST

(CA)

IREDELL COUNTY HEALTH DEPARTMENT

STATESVILLE 704-878-5305 MOORESVILLE 704-664-5281

IMPROVEMENT PERMIT / AUTHORIZATION TO CONSTRUCT / OPERATION PERMIT / EXISTING SYSTEM INSPECTION

PERMIT# 142718 PIN# 4765-43-1427 DATE 9-26-07

OWNER OR APPLICANT BRAWLEY CONSTRUCTION CO. PHONE: Business 704-902-4744 Home 704-663-5270

ADDRESS 954 OAK RIDGE FARM HWY MOORESVILLE, NC 28115

LOCATION US 64 EAST, ON RIGHT AT VANCE PO ROAD, (SR 2317)

SUBDIVISION _____ BLOCK / SECTION _____ LOT _____ LOT AREA 0.669 ACRE SITE CLASS. PS DESIGN FLOW 200 L.T.A.R. 0.20 GPD/FT²

Septic Tank: 1500 Gallons; STB 248 Date 8-21-07
Pump Tank: _____ Gallons; PT _____ Date _____
Pump Make: _____ Model _____ Serial No. _____
Nitrification Field: No Fields 1 Square Feet 60 TO 1000 Linear Feet 250
No Lines FIVE Trench Width 36" Max Trench Bottom Depth 36" Gravel Depth N/A

☑ New System ☐ Repair ☐ Expansion System Type: I II III IV V VI
System Description: 25% REDUCTION, GRAVITY
Repair System Description: 25% REDUCTION, PUMP
Maintenance Agreement Required: ☐ Yes ☑ No
☑ Gravity ☐ Pressure

☐ House/Mod. Home No. Bedrooms ____
☐ Mobile Home No. Persons ____
☑ Business No. Employees 6
☐ Other W/ 7510 SF RETAIL


Water Supply: ☐ Individual ☑ Public ☐ Community

☑ Slab ☐ Crawl Space ☐ Basement w/plumbing ☐ Basement wo/plumbing


Comments/Conditions: FLOW REDUCTION GRANTED TO DOLLAR GENERAL STORES PER TRISH ANGIOLI (2) INSTALL 25% REDUCTION SYSTEM ON CONTOUR USING SERIAL DISTRIBUTION

Comments:/Conditions: Orange Brown Baleo Septic tank risers End cap distribution

INITIAL SITE SKETCH

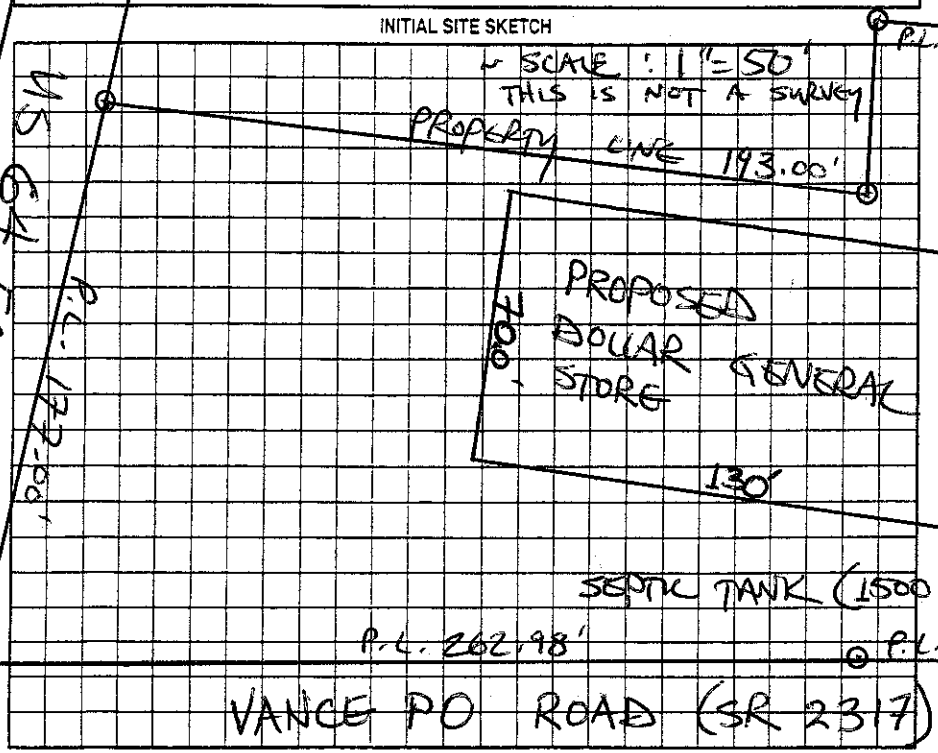

AS BUILT SKETCH

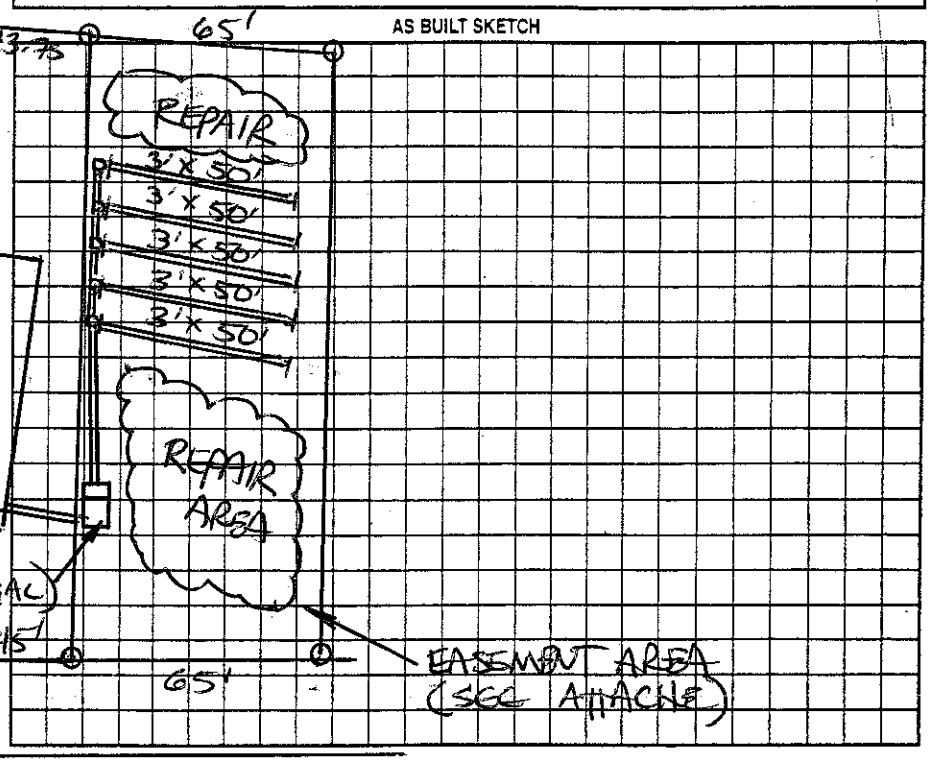

Permit can be suspended or revoked if any false information is supplied toward securing the permit/any unauthorized changes are made to the site/any unauthorized changes are made in the installation of the system. Improvement Permit with plat valid without expiration ☐ Improvement Permit with site plan valid for sixty months ☑ Authorization to Construct is valid for a period equal to that of Improvement Permit – not to exceed sixty months.

Signed: _____ date 9-26-07 Installed by: James Boydlen

Improvement Permit by: STEVE HEDRICK date 9-26-07 Operation Permit by: Kelly Cook date 10-30-07

Authorization to Construct by: STEVE HEDRICK date 9-26-07 Existing System Inspection by: _____ date _____

HEALTH DEPT. COPY: WHITE OWNER COPY (FINAL): YELLOW OWNER COPY (INITIAL): PINK