IREDELL COUNTY HEALTH DEPARTMENT

Statesville Phone TR 3-7271 Mooresville Phone NO 3-1271

PERMIT TO INSTALL SEPTIC TANK

Permit NO. _____ Permit Date 5-9 1966

Owner Evelyn Gracey Address Rt 5 Statesville, NC.

Installed By Owner Address ---


Location of Property Hwy 64 E. Left 21 to Gracey Ave. to Rt.

Tank		Capacity		Length of Lines		Fixtures	
Block	(✓)	1000	( )	225'	(✓)	No. of Baths	( )
Precast	( )	1250	(✓)	250'	( )	Dishwasher	( )
		1500	( )	Other _____		Garbage Grdr.	( )
		Other _____				Other _____	

NOTIFY HEALTH DEPARTMENT AT LEAST EIGHT HOURS BEFORE TANK IS TO BE INSPECTED.

Final Inspection 5-9 1966 Approved (✓) Disapproved ( )

Remarks _____

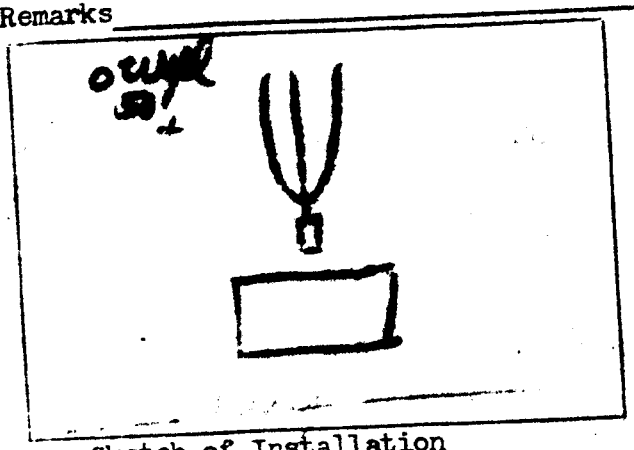

Sketch of Installation

Sanitarian