IREDELL COUNTY HEALTH DEPARTMENT - *ENVIRONMENTAL HEALTH* ☒ STATESVILLE OFFICE 704-878-5305 ☐ MOORESVILLE OFFICE 704-664-5281

IMPROVEMENT PERMIT / AUTHORIZATION TO CONSTRUCT / OPERATION PERMIT / EXISTING SYSTEM INSPECTION

PERMIT # Repair PIN # 4765436001 DATE 7-24-12

OWNER Abilene Church Parsonage APPLICANT: PHONE: Home/Cell # 704 872 5165 Business #

SITE ADDRESS 108 Bell Farm Rd OWNER / APPLICANT ADDRESS

SITE DIRECTIONS 64E, Turn (R) on Bell Farm Rd. 1st house on (R)

SUBDIVISION n/a BLOCK / SECTION n/a LOT # n/a LOT AREA 6.72 Ac DESIGN FLOW 360 L.T.A.R. Ex

Septic Tank 1000 Gallons: STB 760 Date 3-29-12 ☒ New System ☒ Repair ☐ Expansion System Type I (II) III IV V VI ☒ Residence No. Bedrooms 3 Water Supply

Pump Tank ____ Gallons: P T ____ Date ____ System Description: 360gpd ☐ Business No. Persons ____ ☒ Private

Pump Make ____ Model ____ Serial # ____ Repair System Description: Tank Replacement ☐ Other No. Employees ____ ☐ Public


No. Nitrification Fields: Ex No. Lines Ex Linear Feet Ex Maintenance Agreement Required ☐ YES ☒ NO ☐ Slab ☒ Crawl Space ☐ Community

Trench Width Ex Max. Trench Bottom Depth Ex Gravel Depth Ex ☒ GRAVITY ☐ PRESSURE ☐ Basement w/plumbing ☐ Basement w/o plumbing

Comments / Conditions

1" = 60'

INITIAL SITE SKETCH

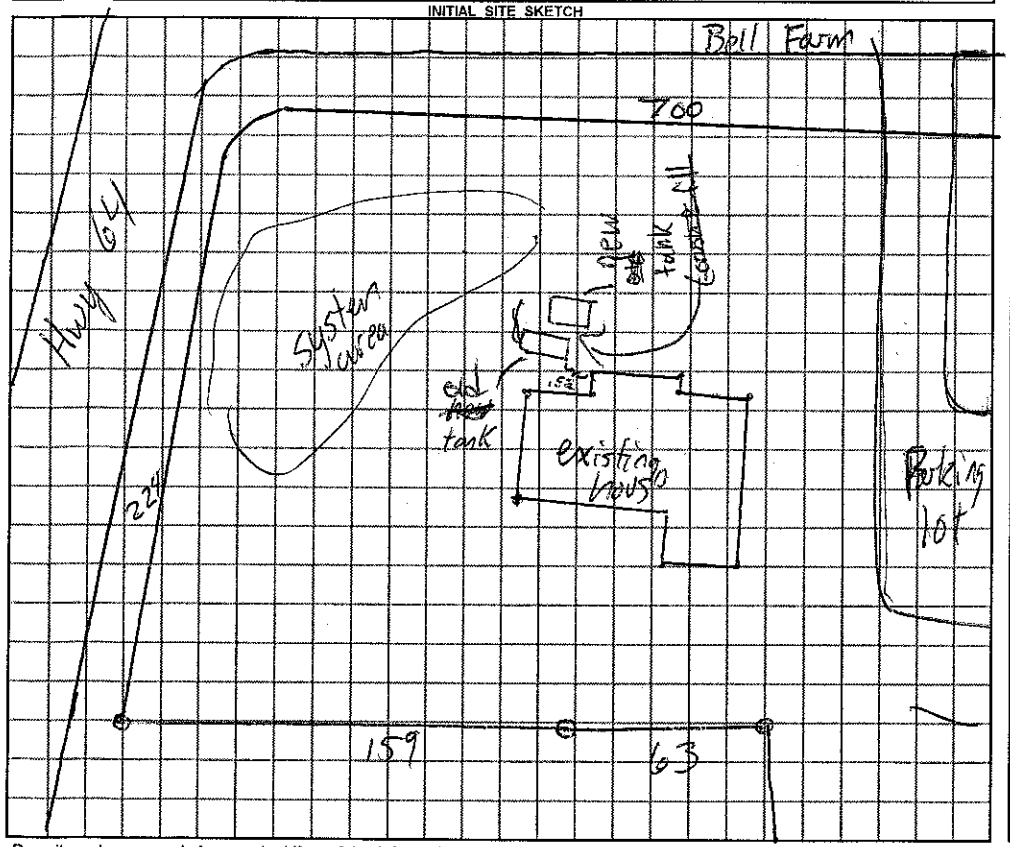

AS BUILT SKETCH

Permit can be suspended or revoked if any false information is supplied toward securing the permit / any unauthorized changes are made to the site / any unauthorized changes are made in the installation of the system.

☐ ***IMPROVEMENT PERMIT*** with plat valid without expiration. ☒ ***IMPROVEMENT PERMIT*** with ~~plat valid without expiration.~~ site plan valid 60 mo. ☒ ***AUTHORIZATION TO CONSTRUCT*** valid for period equal to IMPROVEMENT PERMIT--not to exceed 60 mo.

Owner / Applicant Signature: ____ Date ____ Installed by: A-1 Backhoe

IMPROVEMENT PERMIT by: James REHS Date 7-24-12 OPERATION PERMIT by: James REHS Date 7-24-12

AUTHORIZATION TO CONSTRUCT by: James REHS Date 7-24-12 Existing System Inspected by: ____ REHS Date ____

YOU SHOULD CONTACT A LOCATOR SERVICE PRIOR TO ANY EXCAVATION

White Copy – Environmental Health YELLOW COPY (Final) Owner / Applicant PINK COPY (Initial) Owner / Applicant