IREDELL COUNTY HEALTH DEPARTMENT

Statesville Phone TR 3-7271 Mooresville Phone NO 3-1271

PERMIT TO INSTALL SEPTIC TANK

Permit No. CK, Land Bldg. Permit Date Feb 22 19 67

Owner Church of Christ Address R # 4 Statesville

Installed By E Hoke Address R 7 -


Location of Property Hwy 64 E. & Bell Rd. Across from Cool Springs Fire Sta. & Beam Store

| Tank | | Capacity | | Length of Lines | | Fixtures | |
|---|---|---|---|---|---|---|---|
| Block | ( ) | 1000 | (4) | 225' | ( ) | No. of Baths | (2) |
| Precast | (4) | 1250 | ( ) | 250' | ( ) | Dishwasher | (4) |
| | | 1500 | ( ) | Other 2 45' | | Garbage Grdr. | ( ) |
| | | Other | | | | Other | |

NOTIFY HEALTH DEPARTMENT AT LEAST EIGHT HOURS BEFORE TANK IS TO BE INSPECTED.

Final Inspection 19 Approved ( ) Disapproved ( )

Remarks Builder & owners state no Garbage Grds. in This house.

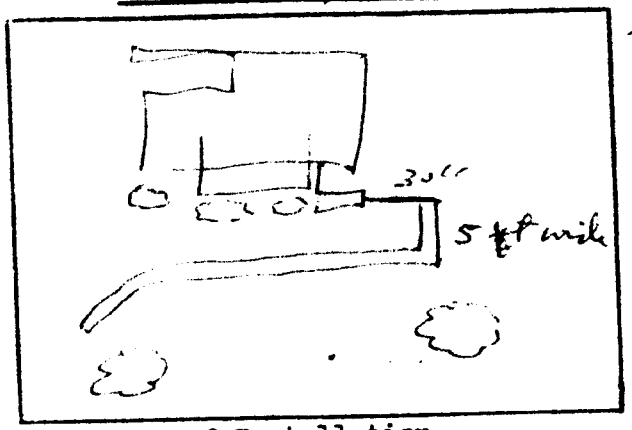


Sketch of Installation

Sanitarian