IREDELL COUNTY HEALTH DEPARTMENT

STATESVILLE 704-878-5305 MOORESVILLE 704-664-5281

IMPROVEMENT PERMIT / AUTHORIZATION TO CONSTRUCT / OPERATION PERMIT / EXISTING SYSTEM INSPECTION

DATE 5-1-01

PERMIT# 094696 PIN# 4765 43 6245

OWNER OR CONTRACTOR FOGAL TRACTOR CO INC PHONE: Business 704-872-5102 Home

ADDRESS 635 MOCKSVILLE HWY, STATESVILLE, NC 28625

LOCATION HWY 64 EAST, ① IN FRONT OF BEAVERS STORE

SUBDIVISION — BLOCK / SECTION — LOT — LOT AREA 3.44 SITE CLASS PS DESIGN FLOW 419 L.T.A.R. .25

Septic Tank: 1800 Gallons: STB 1012 Date 1-26-2001

Pump Tank: Gallons: PT Date

Pump Make: Model Serial No.

Nitrification Field: No Fields 1 Square Feet 1676' Linear Feet 560'

No Lines 7 Trench Width 36" Max Trench Bottom Depth 36" Gravel Depth 12"

[X] New System [ ] Repair System Type: I (II) III, IV, V, VI

System Description: CONV GRAV

Repair System Description: LP PANEL

Maintenance Agreement Required: [ ] Yes [X] No

[X] Slab [ ] Crawl Space [ ] Basement w/plumbing [ ] Basement wo/plumbing

[ ] House/Mod. Home No. Bedrooms

[ ] Mobile Home No. Bathrooms

[X] Business No Employees 11


[ ] Other 2 sales space

Water Supply: [ ] Individual [X] Public [ ] Community


Comments:/Conditions ① INSTALL FRENCH DRAIN 48" DEEP AROUND SYSTEM TO DAYLIGHT ② USE 7 DROP BOXES ③ MAINTAIN SETBACKS ESPECIALLY AROUND FRENCH DRAIN ④ RESTRICT VEHICLE TRAFFIC OVER RAINFIELD ⑤ INSTALL LINES

Comments:/Conditions ON CONTOUR ⑥ DO NOT FILL or cut any soil in repair area ⑦ SYSTEM IS FLAGGED OUT & COMPLEX POLYLOK FILTER & CISELS

INITIAL SITE SKETCH

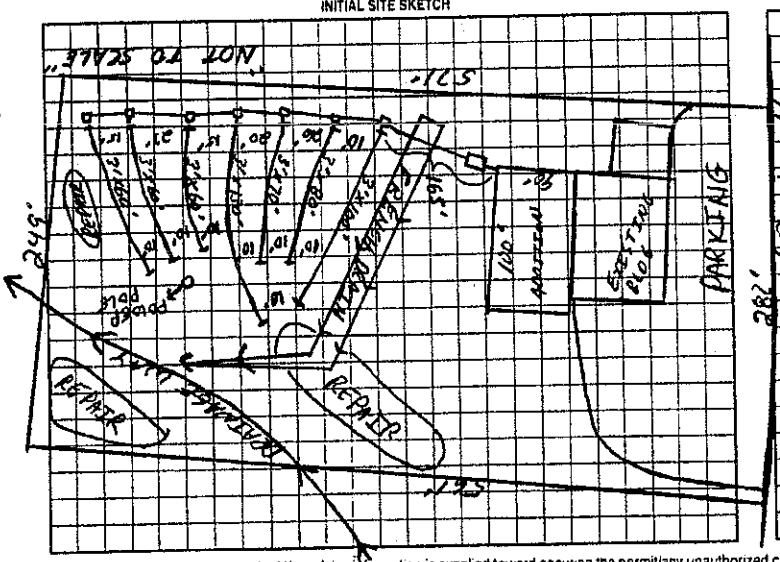

AS BUILT SKETCH

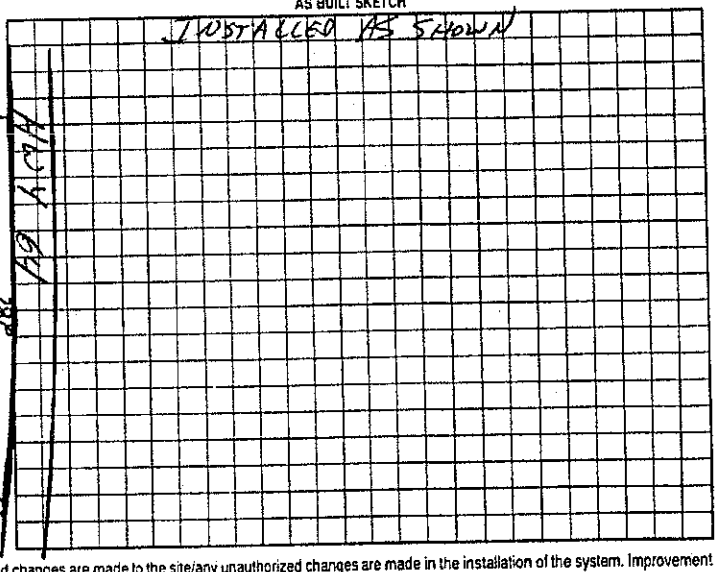

Permit can be suspended or revoked if any false information is supplied toward securing the permit/any unauthorized changes are made to the site/any unauthorized changes are made in the installation of the system. Improvement Permit with plat valid without expiration. Improvement Permit with site plan valid for sixty months. Authorization to Construct is valid for a period equal to that of Improvement Permit – not to exceed sixty months.

Signed: Clyde Fedley date 5-2-01

Improvement Permit by: John Cook RSI date 5-2-01

Authorization to Construct by: John Cook RSI date 5-2-01

Installed by: DAVID YOUNTZ

Operation Permit by: John Cook EC date 8-23-01

Existing System Inspection by: date

HEALTH DEPT. COPY WHITE OWNER COPY (FINAL) YELLOW OWNER COPY (INITIAL) PINK

Location of the proposed STORAGE ADDITION addition does not appear to impact the existing on-site septic system.**NOTE: KEEP MIN. 5' FROM SYSTEM

R. STEVE HEDRICK REHS

Date: MARCH 1, 2013

ICHD-Environmental Health Division