IREDELL COUNTY HEALTH DEPARTMENT

Statesville Phone TR 3-7271 Mooresville Phone NO 3-1271

PERMIT TO INSTALL SEPTIC TANK

Permit No. 139 Permit Date 3-14 1972

Owner Miss MARIANNA NICHOLSON Address STATESVILLE, NC

Installed By SAM STEWART Address TROUTMAN, NC


Location of Property TROUTMAN - PERTH CHURCH RD - THEN RIGHT ON STATE PARK RD. THEN LEFT ON RD. #1331 - THEN RIGHT ON RD #1434 HOUSE ON RT.

Tank		Capacity		Length of Lines		Fixtures	
Block	( )	1000	(✓)	225'	(✓)	No. of Baths	(1)
Precast	(✓)	1250	( )	250'	( )	Dishwasher	( )
		1500	( )	Other		Garbage Grdr.	( )
		Other				Other	

NOTIFY HEALTH DEPARTMENT AT LEAST EIGHT HOURS BEFORE TANK IS TO BE INSPECTED.

Final Inspection 3-14 1972 Approved (✓) Disapproved ( )

Remarks

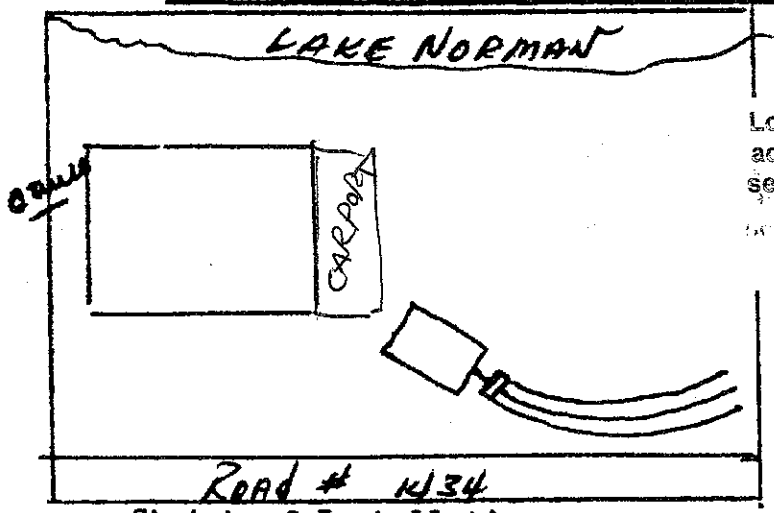

Sketch of Installation

Location of the proposed CARPORT addition does not appear to impact the existing on-site septic system.**NOTE: KEEP MIN. 5' FROM SYSTEM

R. STEVE HEDRICK REHS

Date: MARCH 5, 2013

ICHD-Environmental Health Division

Sanitarian