IREDELL COUNTY HEALTH DEPARTMENT

Statesville Phone TR 3-7271 Mooresville Phone NO 3-1271

PERMIT TO INSTALL SEPTIC TANK

Permit NO. _____ Permit Date Nov - 28 1960

Owner Cool Springs Vol Fire Dept Address Mocksville Hwy.

Installed By _____ CLYDE HOWE Address RT -


Location of Property Across from Rex Beaver store

Tank		Capacity		Length of Lines		Fixtures	
Block	( )	800	( )	150'	( )	No. of Baths	(2) old
Precast	(✓)	900	( )	175'	( )	Dishwasher	( )
		1000	(✓)	200'	( )	Garbage Grdr.	( )
Lash		1100	( )	225'	(✓)	Auto-Washer	( )
		1200	( )	250'	( )	Other	
		Other		Other			

NOTIFY HEALTH DEPARTMENT AT LEAST EIGHT HOURS BEFORE TANK IS TO BE INSPECTED.

Final Inspection Nov. 28 1960 Approved (✓) Disapproved ( )

Remarks well 75'

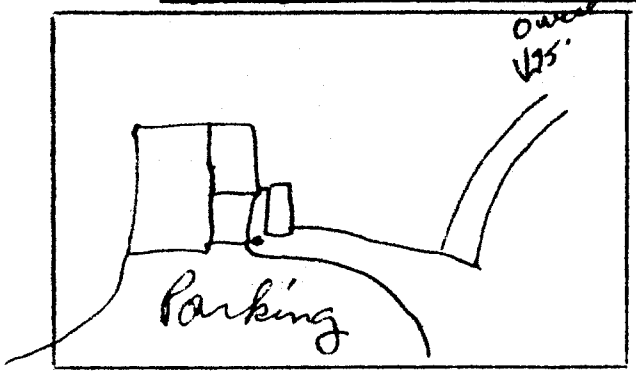

Sketch of Installation

Self app -

RT

Sanitarian