IREDELL COUNTY HEALTH DEPARTMENT

Statesville Phone TR 3-7271 — Mooresville Phone MO 3-1271

PERMIT TO INSTALL SEPTIC TANK

Permit No. _____ Permit Date 4-11 1968

Owner Bowers Cash Store Address Statesville, NC.

Installed By Clyde Hoke Address Statesville, NC.


Location of Property Hwy 64 E. -

Tank		Capacity		Length of Lines		Fixtures	
Block	( )	1000	( )	225'	( )	No. of Baths	( )
Precast	( )	1250	( )	250'	( )	Dishwasher	( )
		1500	( )	Other _____		Garbage Grdr.	( )
		Other _____				Other _____	

NOTIFY HEALTH DEPARTMENT AT LEAST EIGHT HOURS BEFORE TANK IS TO BE INSPECTED.

Final Inspection 4-11 1968 Approved (✓) Disapproved ( )

Remarks _____

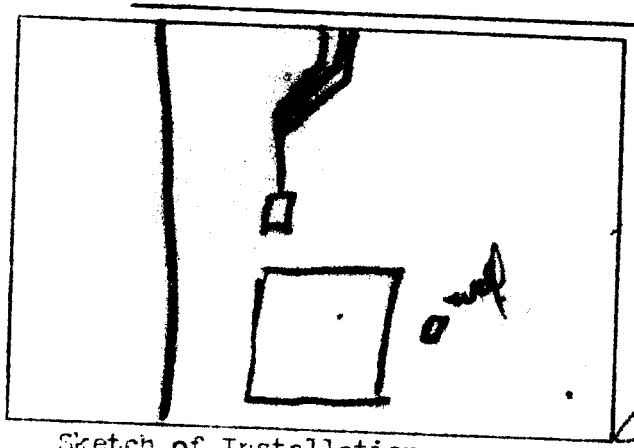

Sketch of Installation

Edward J. Hutchins EHS

Sanitarian