COUNTY HEALTH DEPARTMENT

STATESVILLE 704-878-5305 (ad) MOORESVILLE 704-664-5281

MENT PERMIT / AUTHORIZATION TO CONSTRUCT / OPERATION PERMIT / EXISTING SYSTEM INSPECTION

015 PIN# 4763459874 83

NT Aston Homes DATE 5-8-08

2125 Statesville NC 28677 PHONE: Business 704-902-0107 Home

ION Lot 15 Briarhill (To) Wedgewood

SUBDIVISION Country Woods BLOCK / SECTION LOT 14 LOT AREA 1.34 SITE CLASS. R5 DESIGN FLOW 360 L.T.A.R. 720

Septic Tank: 1000 Gallons: STB 1000 Date 3-26-08

Pump Tank: 1000 Gallons: PT 17 Date 7-31-08

Pump Make: Gould Model WE05FH Serial No.

Nitrification Field: No Fields 1 Square Feet 800 Linear Feet ~~450~~ 450

No Lines 5 Trench Width 36" Max Trench Bottom Depth 25" Gravel Depth ☐ Gravity ☐ Pressure

☑ New System ☐ Repair ☐ Expansion System Type: I II III IV V VI

System Description: 25% Pump fm

Repair System Description: 20% Cap Fm

Maintenance Agreement Required: ☐ Yes ☑ No

☑ House/Mod. Home ☐ Mobile Home ☐ Business ☐ Other

No. Bedrooms ___ No. Persons ___ No. Employees ___

Water Supply: ☐ Individual ☑ Public ☐ Community

☐ Slab ☐ Crawl Space ☑ Basement w/plumbing ☐ Basement wo/plumbing

Comments:/Conditions:

A 25" Trench Depth Maf

Comments:/Conditions:

A front of House must have Crawl Space or Slab, due to setback from Basement

INITIAL SITE SKETCH

See ATTACHed By: S & ME

AS BUILT SKETCH

Maintain all setbacks

Install Curtain

Repair #3 LTAR

Install 1HP - Septic pump tank use

10-23-08 - Liner - Lab

A Need to adjust Flats 11/8

Permit can be suspended or revoked if any false information is supplied toward securing the permit/any unauthorized changes are made to the site/any unauthorized changes are made in the installation of the system. Improvement Permit with plat valid without expiration ☐ Improvement Permit with site plan valid for sixty months ☑ Authorization to Construct is valid for a period equal to that of Improvement Permit – not to exceed sixty months.

Signed: _____ date 5-29-08

Improvement Permit by: Rusty Cook date 5-8-08

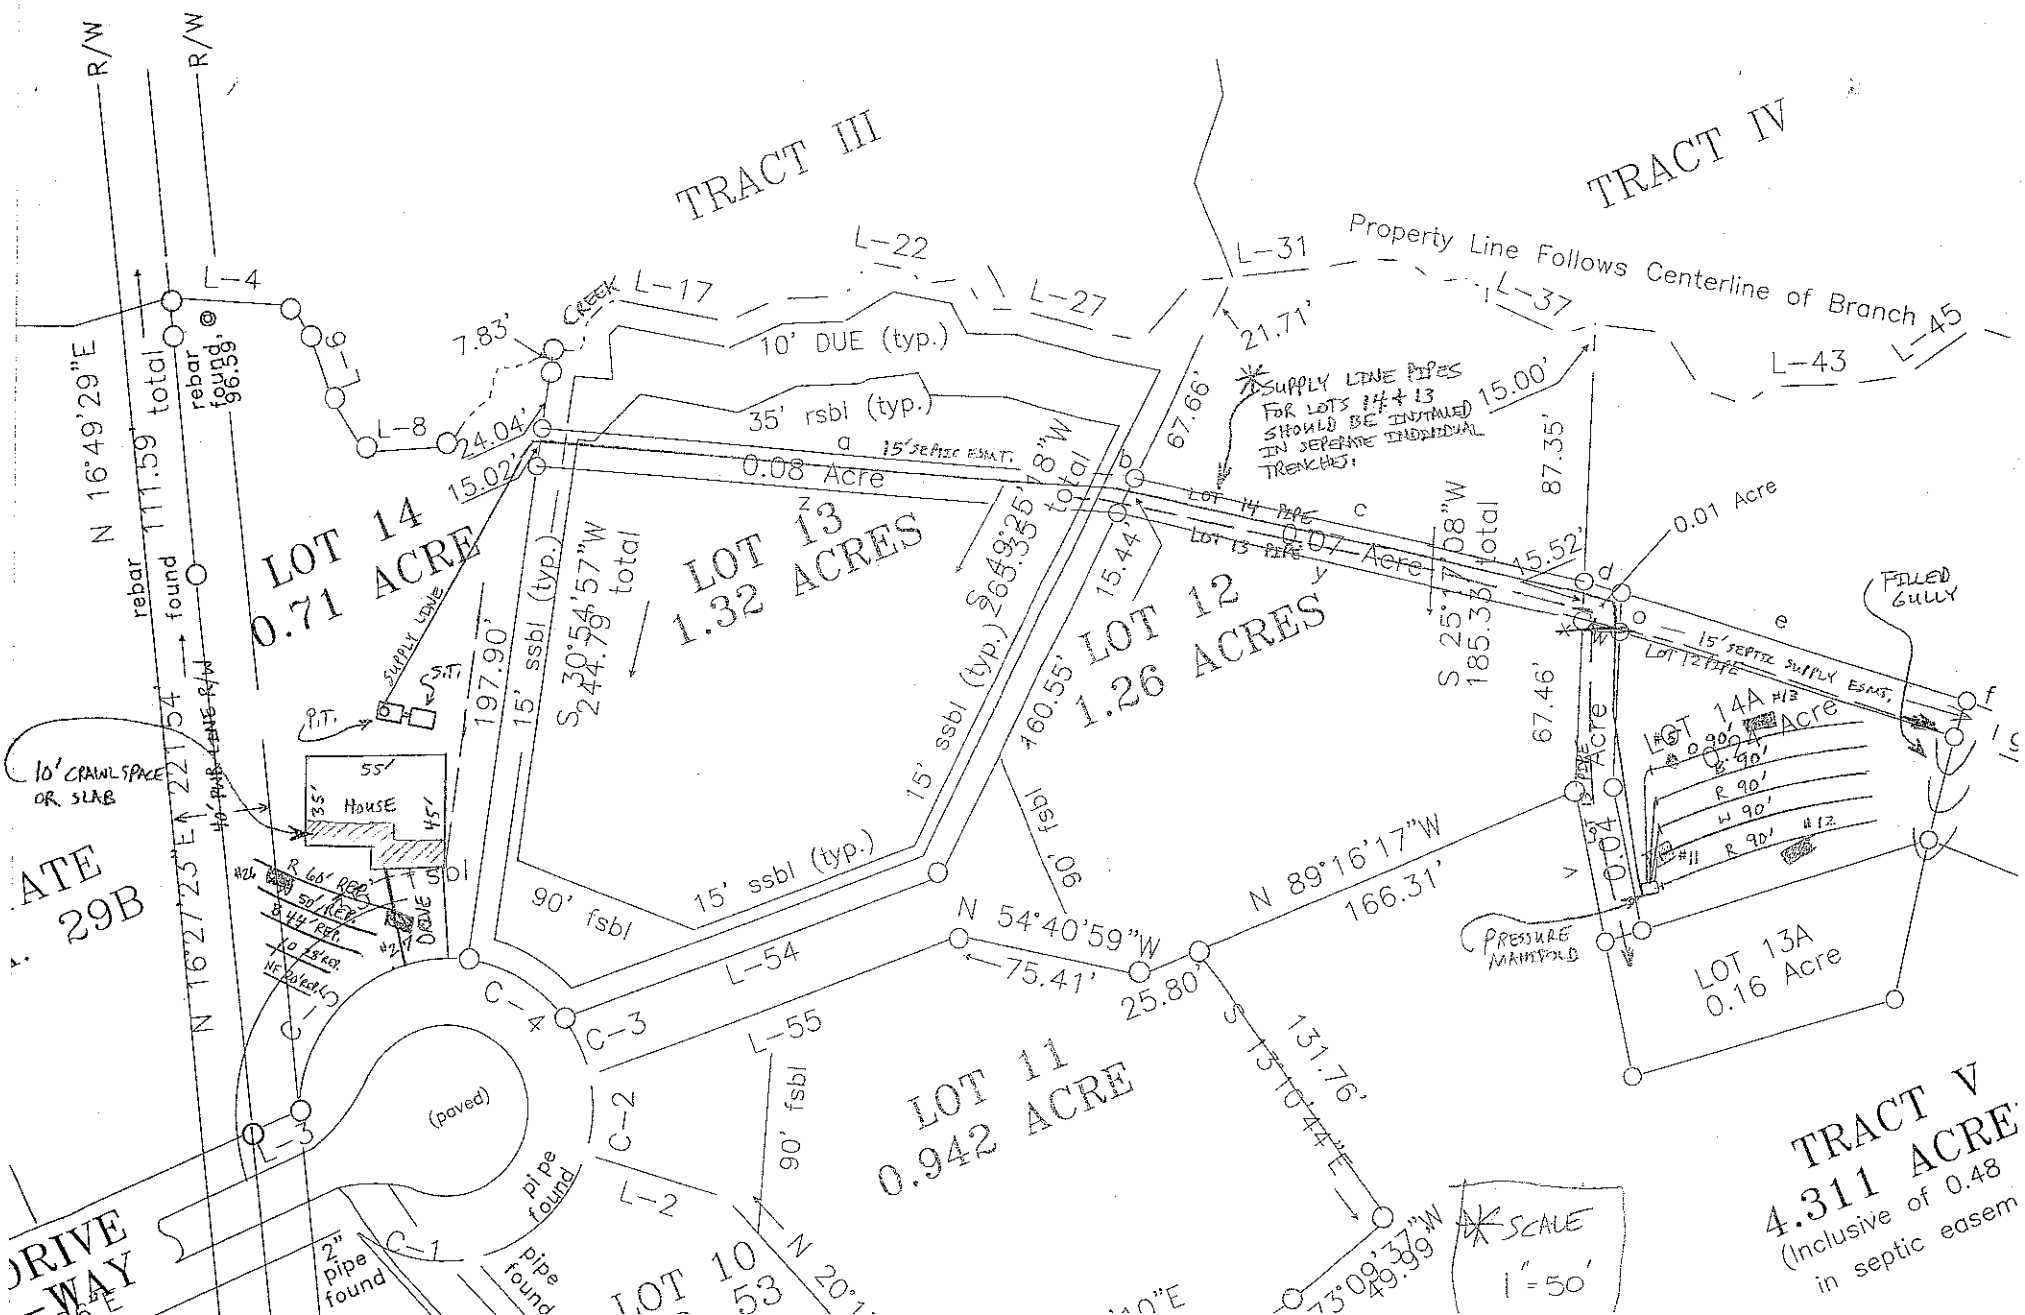
Authorization to Construct by: Rusty Cook date 5-29-08

Installed by: Craig Thompson

Operation Permit by: Rusty Cook date 11-26-08

Existing System Inspection by: _____ date _____

HEALTH DEPT. COPY: WHITE OWNER COPY (FINAL): YELLOW OWNER COPY (INITIAL): PINK


TRACT III
TRACT IV
Property Line Follows Centerline of Branch
R/W
R/W
N 16°49'29"E
rebar found @ 96.39'
rebar 111.59' total
N 16°27'25"E 221.54'
L-4
L-6
L-8
L-17
L-22
L-27
L-31
L-37
L-43
L-45
CREEK
7.83'
24.04'
10' DUE (typ.)
35' rsbl (typ.)
15.02'
a
15' SEPTIC EASMT.
0.08 Acre
LOT 14
0.71 ACRE
LOT 13
1.32 ACRES
LOT 12
1.26 ACRES
LOT 11
0.942 ACRE
S 30°54'57"W
244.79' total
197.90'
15' ssbl (typ.)
S 26°49'35"W
460.55'
15.44'
67.66'
21.71'
SUPPLY LINE PIPES FOR LOTS 14 & 13 SHOULD BE INSTALLED IN SEPERATE INDIVIDUAL TRENCHES.
15.00'
87.35'
S 25°17'08"W
185.35' total
15.52'
0.01 Acre
0.07 Acre
LOT 14 PIPE
LOT 13 PIPE
b
c
d
e
f
y
SUPPLY LINE
P.T.
10' CRAWLSPACE OR SLAB
HP PWR LINE R/W
House
55'
35'
45'
DRIVE
#2
#1
R 66' Rad.
50' Rad.
8.44' Rad.
10' Rad.
N.F. Property
DRIVE
C-1
C-2
C-3
C-4
L-2
L-3
L-54
L-55
90' fsbl
N 54°40'59"W
75.41'
25.80'
N 89°16'17"W
166.31'
S 13°10'44"E
131.76'
N 20.1
(paved)
pipe found
2" pipe found
pipe found
LOT 10
53
67.46'
0.04 Acre
LOT 12 PIPE
15' SEPTIC SUPPLY EASMT.
FILLED GULLY
LOT 14A #13
0.09 Acre
R 90'
W 90'
#12
#11
PRESSURE MANIFOLD
LOT 13A
0.16 Acre
SCALE
1" = 50'
TRACT V
4.311 ACRE
(Inclusive of 0.48
in septic easem