CI

IREDELL COUNTY HEALTH DEPARTMENT

STATESVILLE 704-878-5305 MOORESVILLE 704-664-5281

IMPROVEMENT PERMIT / AUTHORIZATION TO CONSTRUCT / OPERATION PERMIT / EXISTING SYSTEM INSPECTION

PERMIT# 10663 PIN# 4765-46-7501 DATE 07-20-02

OWNER OR CONTRACTOR NYSTROM HOMES PHONE: Business 704-400-2996 Home

ADDRESS 18716 W CATAWBA AVE SUITE 370 CORNELIUS, NC 28031

LOCATION 64E, @ RIVERHILL RD, @ OAKHAVEN, LOT 29 ON RT, 2ND LOT

SUBDIVISION COUNTRY WOODS BLOCK / SECTION LOT 29 LOT AREA 16,913 SF ~~20,038 SF~~ SITE CLASS PS DESIGN FLOW 360 L.T.A.R. .25

Septic Tank: 1060 Gallons: STB 1007 Date 4-15-02
Pump Tank: Gallons: PT Date
Pump Make: Model Serial No
Nitrification Field: No Fields 1 Square Feet EQ=1440' Linear Feet 360'
No Lines 3x120' Trench Width 36" Max Trench Bottom Depth 24"

X New System ☐ Repair System Type: I, II, III, IV, V, VI
System Description: GPA1 2596LED
Repair System Description: LP PAVEC
Maintenance Agreement Required: ☐ Yes X No
Gravel Depth N/A X Slab X Crawl Space ☐ Basement w/plumbing ☐ Basement wo/plumbing


X House/Mod. Home No. Bedrooms 3
☐ Mobile Home No. Bathrooms 2
☐ Business No. Employees
☐ Other

Water Supply: ☐ Individual X Public ☐ Community


Comments/Conditions: ① NOTE MAXIMUM TRENCH BOTTOM DEPTH ② SYSTEM IS ENTIRELY FLAGGED OUT ③ INSTALL FRENCH DRAIN 36" DEEP TO DAYLIGHT

Comments/Conditions: ④ NEED TO SEE UP PATIO PLAT BY SIGNING OFF WITH NEW MOVED PROPERTY. NEIGHBOR SEPTIC LINES ARE ON LINE & THIS WILL MAKE THEM 10' OFF NEW P/L. THIS OCCURED WHEN LINE WAS INCORRECTLY LOCATED ~~INITIALED~~

INITIAL SITE SKETCH "NOT TO SCALE"

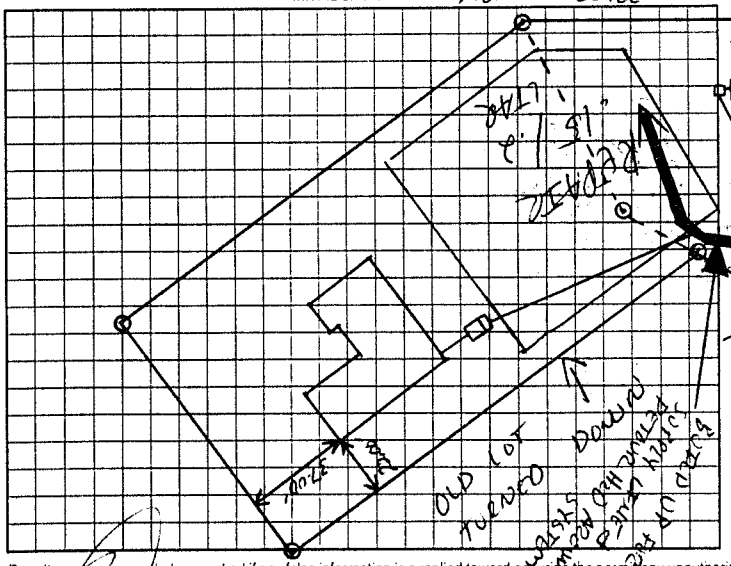

AS BUILT SKETCH

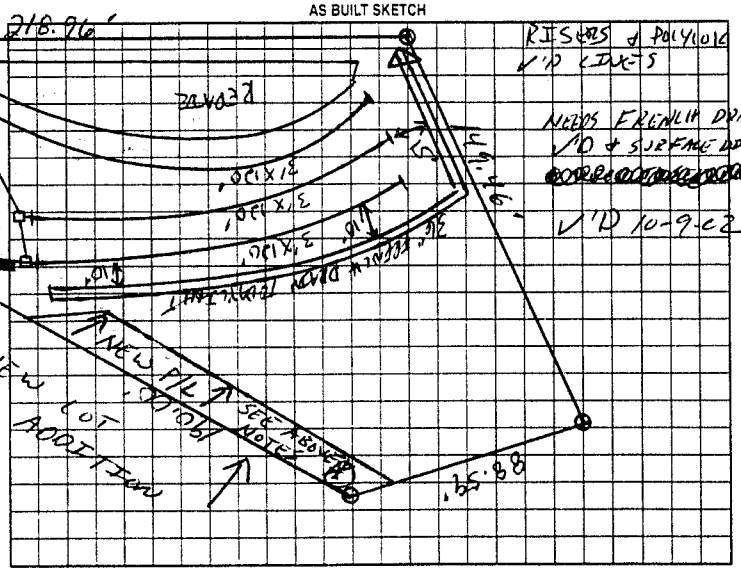

Permit can be suspended or revoked if any false information is supplied toward securing the permit any unauthorized changes are made to the site any unauthorized changes are made in the installation of the system. Improvement Permit with plat valid without expiration. Improvement Permit with site plan valid for sixty months. Authorization to Construct is valid for a period equal to that of Improvement Permit – not to exceed sixty months

Signed: date

Improvement Permit by: RS date 7-22-02

Authorization to Construct by: RS date 7-22-02

Installed by: WAYNE CLONTZ

Operation Permit by: RS date 10-9-02

Existing System Inspection by: date

HEALTH DEPT. COPY: WHITE OWNER COPY (FINAL): YELLOW OWNER COPY (INITIAL): PINK