IREDELL COUNTY HEALTH DEPARTMENT

STATESVILLE 704-878-5305 CI MOORESVILLE 704-664-5281

IMPROVEMENT PERMIT / AUTHORIZATION TO CONSTRUCT / OPERATION PERMIT / EXISTING SYSTEM INSPECTION

PERMIT# 106319 PIN# 4765-46-8205.2 DATE 06-04-02

OWNER OR CONTRACTOR NYSTROM HOMES LLC PHONE Business Home 704-896-9886

ADDRESS 18716 W CATAWBA AVENUE SUITE 370 CORNELIUS, NC 28031

LOCATION 64E, ⓒ RIVERHILL RD, ⓡ OAK HAVEN Ⓓ, 1ST RD ATTOP ON RT

SUBDIVISION OAK HAVEN BLOCK / SECTION LOT LOT AREA 1.31 AC SITE CLASS PS DESIGN FLOW 360 L.T.A.R. .82

Septic Tank: 1000 Gallons: STB 1067 Date 8-28-02

Pump Tank: Gallons: PT Date

Pump Make: Model Serial No

Nitrification Field: No Fields 1 Square Feet 1800 Linear Feet 450

No Lines 6x75' Trench Width 36" Max Trench Bottom Depth 24" Gravel Depth N/A

X New System ☐ Repair System Type: I. II. III. IV. V.

System Description: [redacted] GRAV 25% REDUCT

Repair System Description: GRAV 25% RED SHALLOW

Maintenance Agreement Required ☐ Yes X No

X Slab ☐ Crawl Space ☐ Basement w/plumbing ☐ Basement wo/plumbing

☐ House/Mod Home ☐ Mobile Home ☐ Business ☐ Other


No. Bedrooms 3 No. Bathrooms 2 No. Employees

Water Supply: ☐ Individual X Public ☐ Community

Comments/Conditions: ① DO NOT CUT POSITIVE DRAINAGE AROUND HOUSE, [redacted] ACCEPTABLE THE WAY IT IS NOW AT TIME OF ④ ② USE FLOW DIVIDER TEE & 4 DROP BOXES ③ INSTALL FRENCH DRAIN 48" DEEP &

Comments/Conditions: MAINTAIN SETBACKS ④ NOTE TRENCH BOTTOM DEPTH ⑤ USE'D HOUSE SITE SETBACKS GIVEN ON PLAT.

INITIAL SITE SKETCH 1"=50'

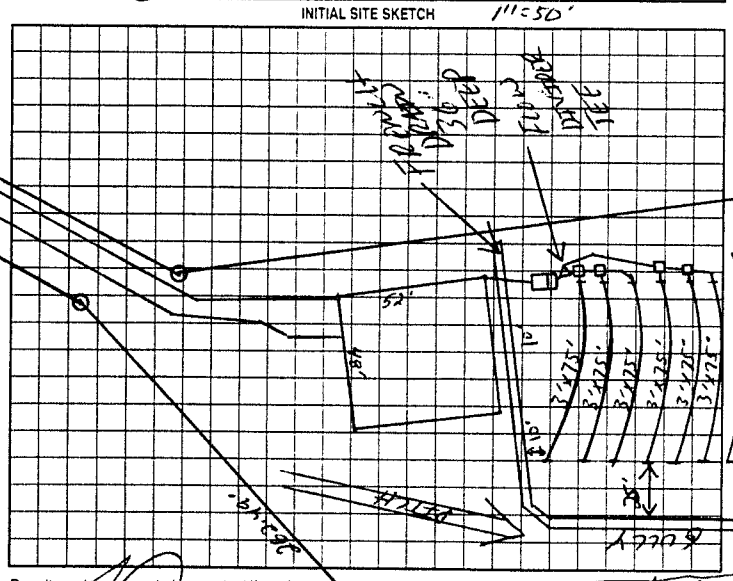

AS BUILT SKETCH

POLYFLOW FILTER & MARKER INSTALLED AS SHOWN NEED TO ✓ FRENCH DRAIN-7 V'D ON 10-7-02

Permit can be suspended or revoked if any false information is supplied toward securing the permit or if unauthorized changes are made to the site any unauthorized changes are made in the installation of the system. Improvement Permit with plat valid without expiration. Improvement Permit with site plan valid for sixty months. Authorization to Construct is valid for a period equal to that of Improvement Permit – not to exceed sixty months

Signed: date installed by WAYNE CLONTZ

Improvement Permit by: date 06-04-02 Operation Permit by: date 10-7-02

Authorization to Construct by: date 06-04-02 Existing System Inspection by: date

HEALTH DEPT COPY: WHITE OWNER COPY (FINAL): YELLOW OWNER COPY (INITIAL): PINK