IREDELL COUNTY HEALTH DEPARTMENT

STATESVILLE 704-878-5305 (c1) MOORESVILLE 704-664-5281

IMPROVEMENT PERMIT / AUTHORIZATION TO CONSTRUCT / OPERATION PERMIT / EXISTING SYSTEM INSPECTION

PERMIT# 106632 PIN# 4765-46-8500 DATE 11-19-02

OWNER OR CONTRACTOR NYSTROM HOMES PHONE: Business 704-896-9886 Home 704-902-5120 CELL #

ADDRESS 18216 W CATAWBA AVE SUITE 370 CORNELIUS, NC 28031

LOCATION 64 EAST ON RIVERHILL RD, R COUNTRYWOOD, LOT # 30 ON RT

SUBDIVISION COUNTRYWOODS BLOCK / SECTION LOT 30 LOT AREA 18987 SQ FT, SITE CLASS. PS DESIGN FLOW 360 L.T.A.R. .3

Septic Tank: 1000 Gallons; STB 825 Date 4-2-04
Pump Tank: Gallons; PT Date
Pump Make: Model Serial No.
Nitrification Field: No Fields 1 Square Feet EQ=1200' Linear Feet 306'
No Lines 6 Trench Width 36" Max Trench Bottom Depth 36" Gravel Depth N/A

[X] New System [ ] Repair System Type: I, II, (III), IV, V, VI
System Description: 6 RUN 2500 REG
Repair System Description: LOW PRESSURE PIPE
Maintenance Agreement Required: [ ] Yes [X] No


[X] House/Mod. Home No. Bedrooms 3
[ ] Mobile Home No. Bathrooms 2
[ ] Business No. Employees
[ ] Other
[X] Slab [ ] Crawl Space [ ] Basement w/plumbing [ ] Basement wo/plumbing

Water Supply: [ ] Individual [X] Public [ ] Community


Comments/Conditions: (1) MAINTAIN SETBACKS (2) MEET PRIOR TO INSTALLATION FOR CONSULTATIVE VISIT. (3) SYSTEM AREA NEEDS SOME GRADING DONE TO CAP THE CONTOURS & DIVERTING

Comments/Conditions: SURFACE H2O AROUND SYSTEM. (4) REGIONAL SOIL SCIENTIST JOE LYNN WAS USED FOR DESIGN OF THIS SYSTEM. SEPTIC TANK W/ MARKER INSTALLED USING "Polylok" FILTER

INITIAL SITE SKETCH "NOT TO SCALE"

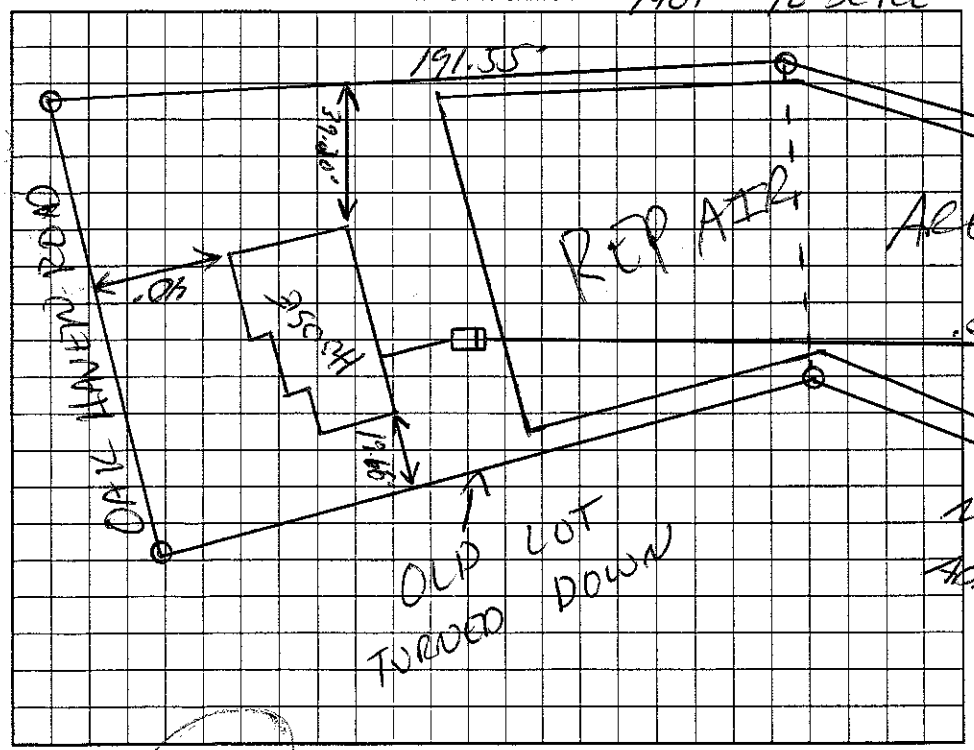

AS BUILT SKETCH

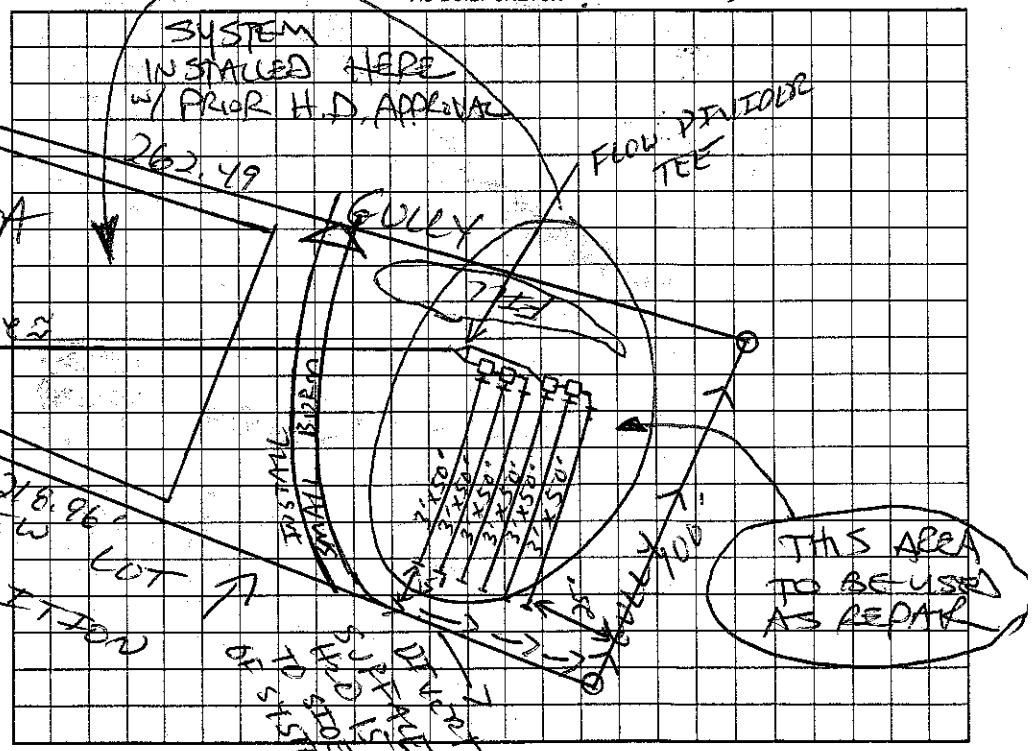

Permit can be suspended or revoked if any false information is supplied toward securing the permit/any unauthorized changes are made to the site/any unauthorized changes are made in the installation of the system. Improvement Permit with plat valid without expiration. Improvement Permit with site plan valid for sixty months. Authorization to Construct is valid for a period equal to that of Improvement Permit – not to exceed sixty months.

Signed: date

Improvement Permit by: date 11-20-02

Authorization to Construct by: date 11-20-02

Installed by: ROWAN Septic

Operation Permit by: STEVE HENDRICK date 6-18-04

Existing System Inspection by: date

HEALTH DEPT. COPY: WHITE OWNER COPY (FINAL): YELLOW OWNER COPY (INITIAL): PINK