IREDELL COUNTY HEALTH DEPARTMENT

STATESVILLE 704-878-5305 CJ MOORESVILLE 704-664-5281

IMPROVEMENT PERMIT / AUTHORIZATION TO CONSTRUCT / OPERATION PERMIT / EXISTING SYSTEM INSPECTION

PERMIT# 106318 PIN# 4765-46-8205.1 MIKE 704-400-2986 DATE 06-03-02

OWNER OR CONTRACTOR NYSTROM HOMES PHONE: Bus RANDY 704-896-9886 Home

ADDRESS 18716 W CATAWBA AVE SUITE 370 CORNELIUS, NC 28625

LOCATION 64 EAST, (L) RIVERHILL, (R) OAK HAVEN (R) 1ST ROAD, AT END ON LEFT

SUBDIVISION COUNTRY WOODS BLOCK / SECTION LOT 1 LOT AREA 1.31 AC SITE CLASS PS DESIGN FLOW 360 L.T.A.R. .2

Septic Tank: 1000 Gallons; STB 1007 Date 04-11-02
Pump Tank: Gallons; PT Date
Pump Make: Model Serial No.
Nitrification Field: No Fields 1 Square Feet 6.0 x 1800 Linear Feet 450'
No Lines 8 Trench Width 36" Max Trench Bottom Depth 24" Gravel Depth N/A

X New System ☐ Repair System Type: I, II, (III), IV, V, VI
System Description: GRAY 25% RED
Repair System Description: LP PANEL
Maintenance Agreement Required: ☐ Yes X No
X Slab ☐ Crawl Space ☐ Basement w/plumbing ☐ Basement wo/plumbing


X House/Mod. Home ☐ Mobile Home ☐ Business ☐ Other
No. Bedrooms 3 No. Bathrooms 2 No. Employees

Water Supply: ☐ Individual X Public ☐ Community

Comments/Conditions: (1) HOUSE IS FLAGGED OUT 7' OF FRENCH DRAIN WHICH IS THE SOLID RED FLAG LINE (2) MAINTAIN SETBACKS (3) INSTALL FRENCH DRAIN 36" DEEP

Comments/Conditions: TO DAYLIGHT DOWN GULLY (4) KEEP SYSTEM 10' BELOW + 15' SIDESLOPE OF FRENCH DRAIN (5) USE FLOW DIVIDER TEE AS DRAWN (6) INSTALL ON CONTOURS + SYSTEM IS ENTIRELY FLAGGED OUT (7) NOTE TRENCH BOTTOM DEPTH

INITIAL SITE SKETCH

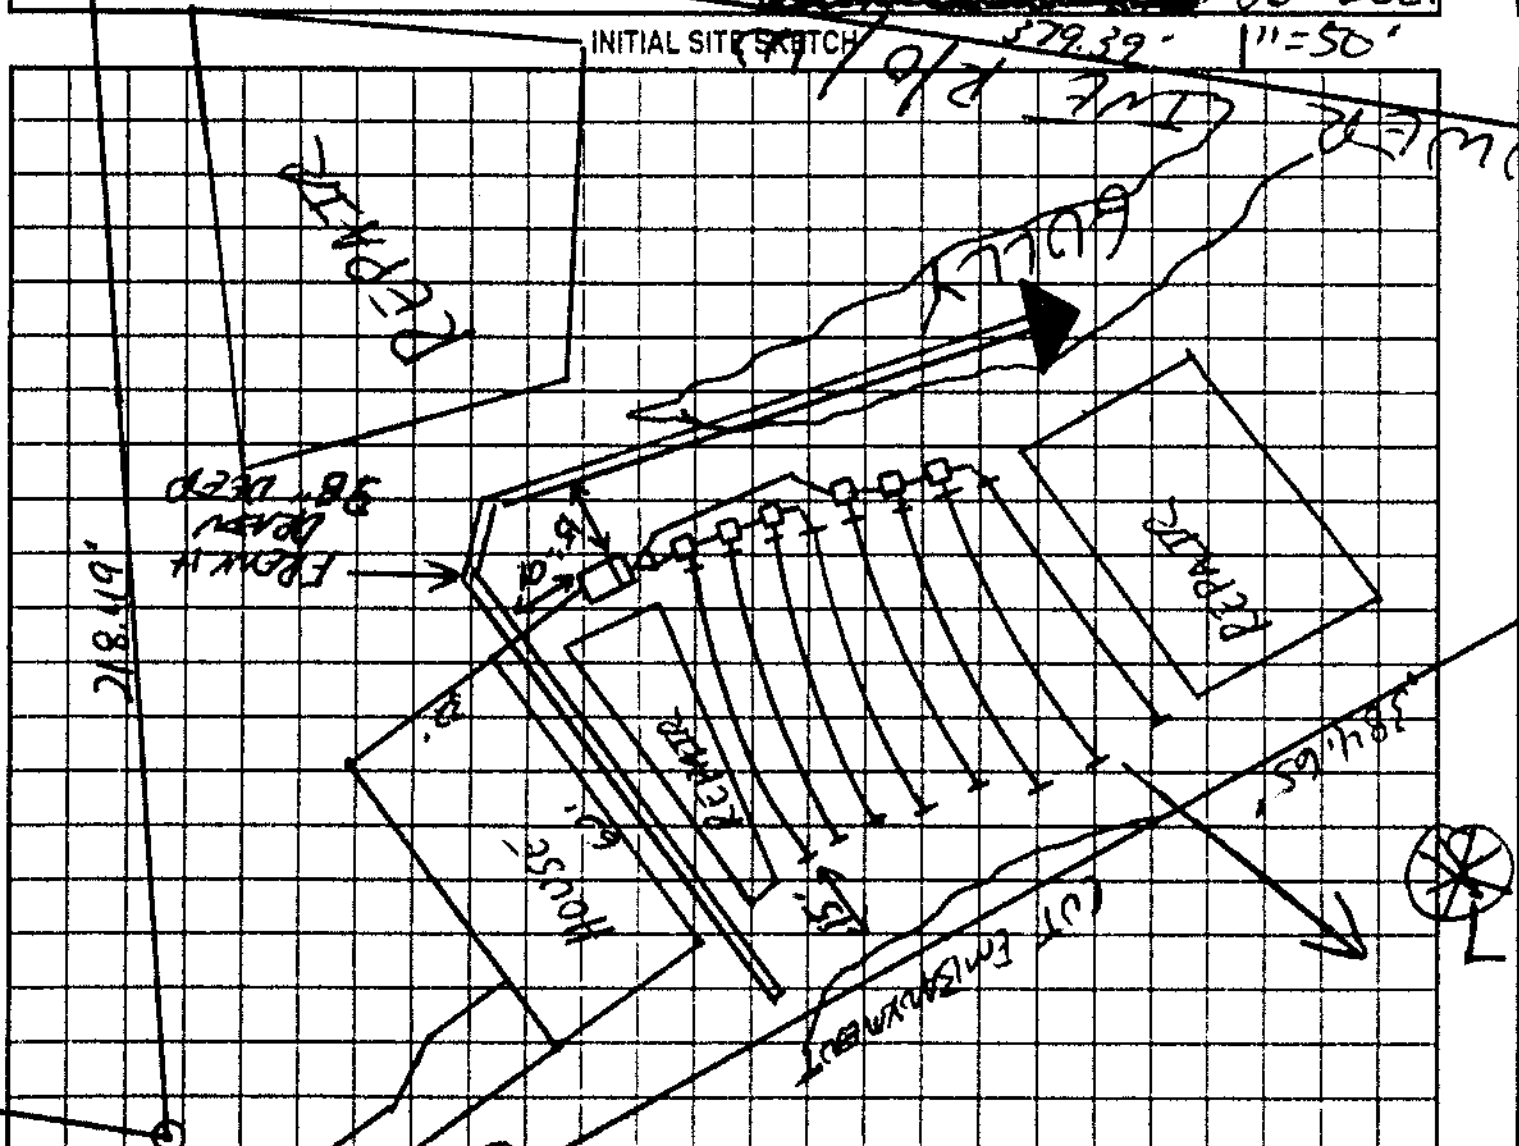

AS BUILT SKETCH

POLYLOK FILTER + MARKER

NEEDS FRENCH DRAIN V'D.
EVERYTHING OK

JOE CANN, PATRICK MITCHELL, + LORNE COOK

LINE LENGTHS / START FROM TOP

1 = 60'	4 = 60'	7 = 50'
2 = 60'	5 = 60'	8 = 45'
3 = 60'	6 = 55'	

Permit can be suspended or revoked if any false information is supplied toward securing the permit/any unauthorized changes are made to the site/any unauthorized changes are made in the installation of the system. Improvement Permit with plat valid without expiration. Improvement Permit with site plan valid for sixty months. Authorization to Construct is valid for a period equal to that of Improvement Permit – not to exceed sixty months

Signed: [signature] date 06/03/02 installed by WAYNE CLONTZ

Improvement Permit by: [signature] RS date 06-30-02 Operation Permit by: [signature] RS date 06-25-02

Authorization to Construct by: [signature] RS date 06-30-02 Existing System Inspection by: date

HEALTH DEPT. COPY: WHITE OWNER COPY (FINAL) YELLOW OWNER COPY (INITIAL) PINK