IREDELL COUNTY HEALTH DEPARTMENT

STATESVILLE 704-878-5305 MOORESVILLE 704-664-5281

IMPROVEMENT PERMIT / AUTHORIZATION TO CONSTRUCT / OPERATION PERMIT / EXISTING SYSTEM INSPECTION

PERMIT# 077895 PIN# 4765 47 7997 DATE 11-13-98

OWNER OR CONTRACTOR RONALD IVEY PHONE: Business 872-2081 Home

ADDRESS 315 RIVER HILL ROAD, STATESVILLE, NC 28677

LOCATION US 64 EAST, TL RIVER HILL ROAD ~ 1.0 MILE ON LEFT AT BOX #315

SUBDIVISION BLOCK / SECTION LOT LOT AREA 2.699 ACRES (TOTAL) SITE CLASS PS DESIGN FLOW 360 L.T.A.R. 0.40 GAL/FT2

Septic Tank: 1000 Gallons; STB 1012 Date 9-23-98
Pump Tank: Gallons; PT Date
Pump Make: Model Serial No.
Nitrification Field: No Fields 1 Square Feet 900 Linear Feet 300
No Lines Four Trench Width 36" Max Trench Bottom Depth 36" Gravel Depth 12"

☑ New System ☐ Repair System Type: ☐ I ☐ II ☐ III ☐ IV ☐ V ☐ VI
System Description: CONVENTIONAL GRAVITY
Repair System Description: CONV. GRAVITY
Maintenance Agreement Required: ☐ Yes ☑ No
☐ Slab ☑ Crawl Space ☐ Basement w/plumbing ☐ Basement wo/plumbing


☐ House/Mod. Home ☑ Mobile Home ☐ Business ☐ Other
No. Bedrooms 3 No. Bathrooms 2 No. Employees

Water Supply: ☐ Individual ☑ Public ☐ Community

Comments/Conditions:

Comments/Conditions:

INITIAL SITE SKETCH

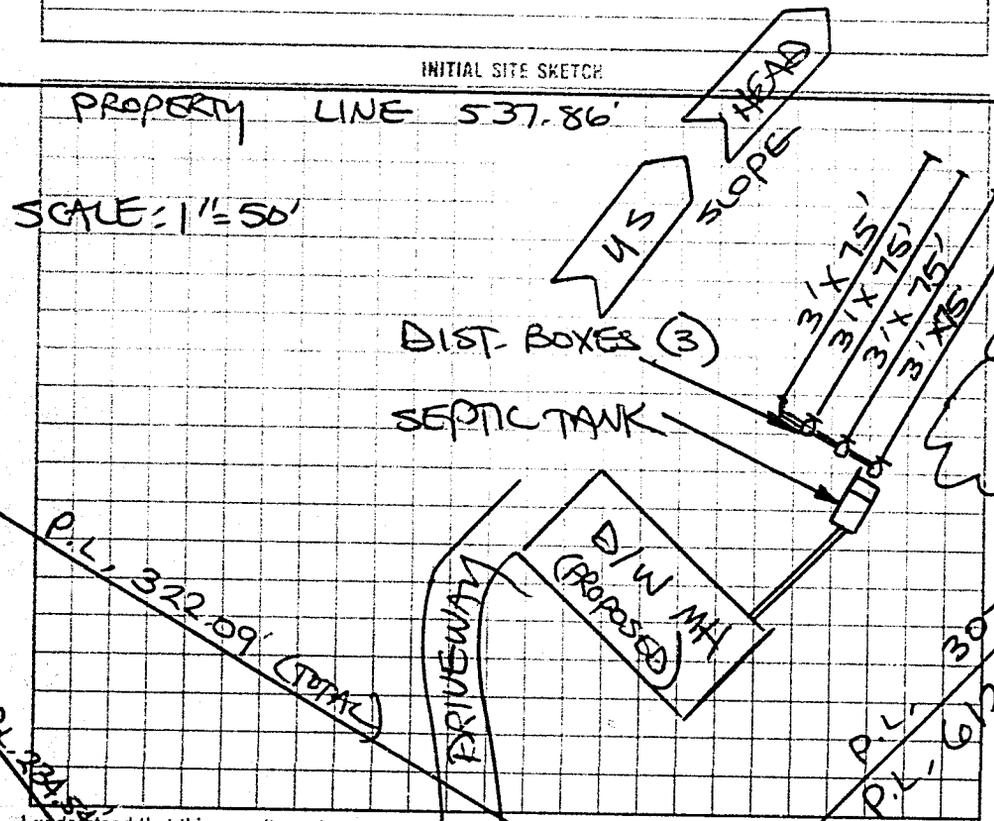

AS BUILT SKETCH

SYSTEM INSTALLED ACCORDING TO INITIAL SITE SKETCH

I understand that this permit can be suspended or revoked if any false information is supplied toward securing the permit/any unauthorized changes are made to the site/any unauthorized changes are made in the installation of the system. Improvement Permit with plat valid without expiration. Improvement Permit with site plan valid for sixty months. Authorization to Construct is valid for a period equal to that of Improvement Permit – not to exceed sixty months.

Signed: Leon Gray date 11-17-98

Improvement Permit by: STEVE HEDRICK date 11-13-98

Authorization to Construct by: STEVE HEDRICK date 11-13-98

Installed by: STEVE JORDAN

Operation Permit by: STEVE HEDRICK date 12-4-98

Existing System Inspection by: date

HEALTH DEPT. COPY: WHITE INSPECTION COPY (FINAL): GREEN OWNER COPY (FINAL): YELLOW INSPECTION COPY (INITIAL): PINK OWNER COPY (INITIAL): GOLD

25200