IREDELL COUNTY HEALTH DEPARTMENT

STATESVILLE 704-878-5305 CI MOORESVILLE 704-664-5281

IMPROVEMENT PERMIT / AUTHORIZATION TO CONSTRUCT / OPERATION PERMIT / EXISTING SYSTEM INSPECTION

PERMIT# 106 868 PIN# 4765-48-8744 DATE

OWNER OR CONTRACTOR FLEETWOOD HOMES / RIVERGREEN LLC PHONE: Business 704-872-0179 Home 704-902-0704

ADDRESS 1270 NORTHSIDE DR STATESVILLE NC 28625

LOCATION 64 E, © RIVERHILL, © RIVERGREEN, © SWEETWATER, LOT # 7 ON LEFT

SUBDIVISION RIVERGREEN BLOCK / SECTION LOT 7 LOT AREA 1.3258 AC SITE CLASS PS DESIGN FLOW 360 L.T.A.R. .25

Septic Tank: 1000 Gallons: STB 1007 Date 6-10-02
Pump Tank: Gallons: PT Date
Pump Make: Model Serial No.
Nitrification Field: No Fields 1 Square Feet 60=1440 Linear Feet 360'
No. Lines 6 Trench Width 36" Max Trench Bottom Depth (24") Gravel Depth N/A

X New System ☐ Repair System Type: I II (III) IV V VI
System Description: 6 GAL 2500 PSD
Repair System Description: PUMP/LP PANEL
Maintenance Agreement Required: ☐ Yes X No


☐ House/Mod. Home No. Bedrooms 3
X Mobile Home D/W No. Bathrooms 2
☐ Business No. Employees
☐ Other
☐ Slab X Crawl Space ☐ Basement w/plumbing ☐ Basement wo/plumbing

Water Supply: ☐ Individual X Public ☐ Community


Comments/Conditions: (1) INSTALL FRENCH DRAIN 18" DEEP & DRAINLINES 24" DEEP DO TO SOILS. (2) INSTALL LINES ON CONTOURS (3) MAINTAIN SETBACKS (4) MUST ABANDON WELL THATS ON THE SIGHT.

Comments/Conditions: POLYLOK FILTER & MARKER INSTALLED AS SHOWN.

INITIAL SITE SKETCH 301.81' 1"=50'

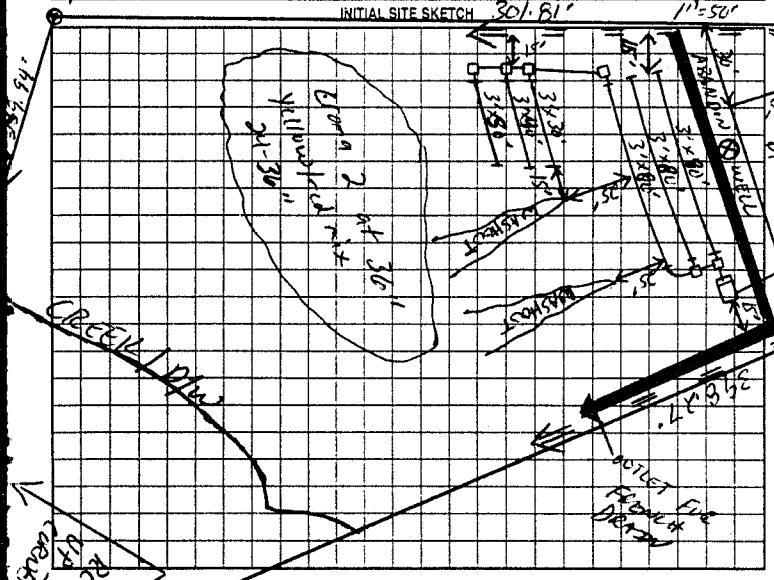

AS BUILT SKETCH

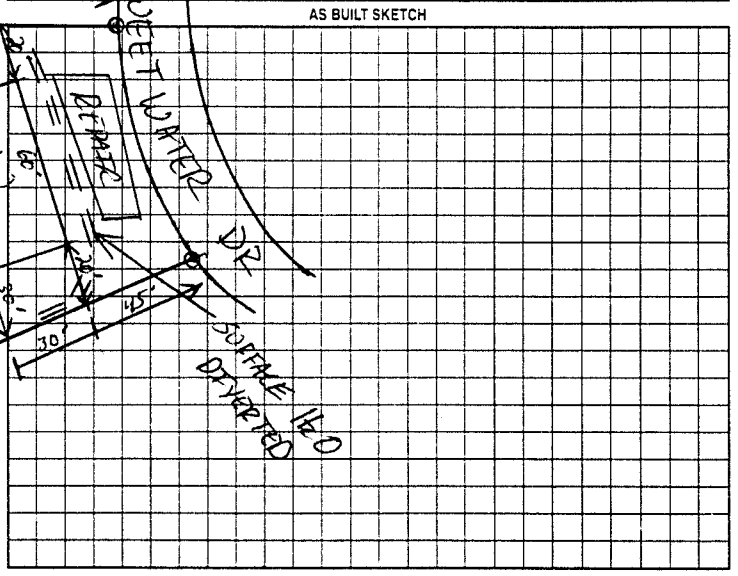

Permit can be suspended or revoked if any false information is supplied toward securing the permit/any unauthorized changes are made to the site/any unauthorized changes are made in the installation of the system. Improvement Permit with plat valid without expiration. Improvement Permit with site plan valid for sixty months. Authorization to Construct is valid for a period equal to that of Improvement Permit - not to exceed sixty months

Signed: date Installed by: JAMES HOLDER

Improvement Permit by: date 08-06-02 Operation Permit by: date 08-09-02

Authorization to Construct by: date 08-06-02 Existing System Inspection by: date

HEALTH DEPT COPY WHITE OWNER COPY (FINAL) YELLOW OWNER COPY (INITIAL) PINK