IREDELL COUNTY HEALTH DEPARTMENT

STATESVILLE 704-878-5305 CI/CF MOORESVILLE 704-664-5281

IMPROVEMENT PERMIT / AUTHORIZATION TO CONSTRUCT / OPERATION PERMIT / EXISTING SYSTEM INSPECTION

PERMIT# 106869 PIN# 4165-48-8961 DATE 11-22-02

OWNER OR CONTRACTOR RIVERGREEN LLC / FLEETWOOD HOMES PHONE: Business 704-872-0179 Home

ADDRESS 131 SWEETWATER DR STATESVILLE, NC 28625

LOCATION 64 EAST, ① RIVERHILL ⑥ RIVERGREEN, ⑦ SWEET WATER LOT #8 ON LEFT

SUBDIVISION RIVERGREEN BLOCK / SECTION LOT 8 LOT AREA .67 AC SITE CLASS PS DESIGN FLOW 360 L.T.A.R. .2

Septic Tank: 1000 Gallons: STB 10 12 Date 7-3-02
Pump Tank: Gallons: PT Date
Pump Make: Model Serial No
Nitrification Field: No. Fields 1 Square ~~Ft~~ 1800' Linear Feet 300'
No. Lines 6 X 38' Trench Width 24" Max Trench Bottom Depth 36"

X New System Repair System Type: I II III IV V VI
System Description: GRAV PANEL
Repair System Description: LP PANEL
Maintenance Agreement Required: Yes X No


House/Mod. Home No. Bedrooms 3
X Mobile Home No. Bathrooms 2
Business No. Employees
Other
Gravel Depth N/A Slab X Crawl Space Basement w/plumbing Basement wo/plumbing

Water Supply: ☐ Individual X Public ☐ Community


Comments/Conditions: ① USE FLOW DIVIDER TEE & 2 DIST. BOX'S WITH SPEED LEVELERS ② FRENCH DRAIN CAN BE PUT ABOVE D/O IF NECESSARY ③ NOTE COMMENTS ABOUT FRENCH DRAIN & DITCH / SURFACE H2O

Comments/Conditions: ⑥ LOT HAS LOTS OF [redacted] TREES THAT HAD TO BE REMOVED. FILL & PACK ALL STUMP HOLES TO PREVENT LINE BLEEDING. SYSTEM WAS PUT IN B-4 HOUSE WAS MOVED ON.

INITIAL SITE SKETCH 1"≈50'

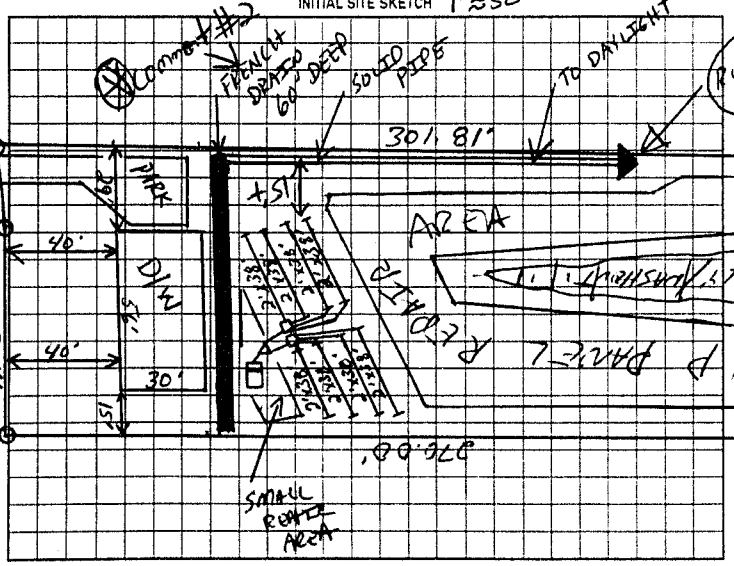

AS BUILT SKETCH

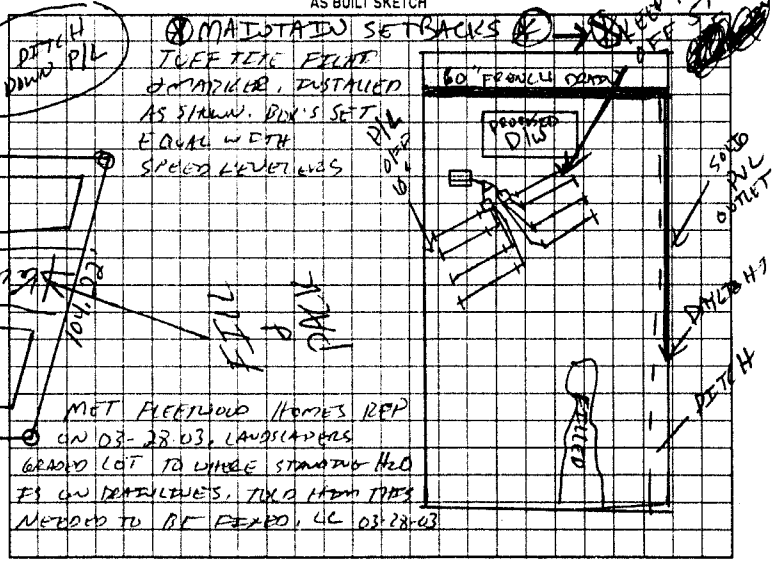

Permit can be suspended or revoked if any false information is supplied toward securing the permit/any unauthorized changes are made to the site any unauthorized changes are made in the installation of the system. Improvement Permit with plat valid without expiration. Improvement Permit with site plan valid for sixty months. Authorization to Construct is valid for a period equal to that of Improvement Permit – not to exceed sixty months.

Signed: [signature] date 11/23/03 Installed by: CRAIG THOMPSON

Improvement Permit by: [signature] date 11-22-02 Operation Permit by: [signature] date 11-25-02

Authorization to Construct by: [signature] date 11-22-02 Existing System Inspection by: date

HEALTH DEPT. COPY: WHITE OWNER COPY (FINAL): YELLOW OWNER COPY (INITIAL): PINK