# IREDELL COUNTY HEALTH DEPARTMENT

STATESVILLE 704-878-5305 MOORESVILLE 704-664-5281

## IMPROVEMENT PERMIT / AUTHORIZATION TO CONSTRUCT / OPERATION PERMIT / EXISTING SYSTEM INSPECTION

PERMIT# 12451 8 PIN# 4765-49-4820 DATE 11/9/04

OWNER OR CONTRACTOR Kaven DeHart PHONE: Business Home

ADDRESS 1190 Buffalo Road Quebeck Tenn 38579

LOCATION Old Mocksville Rd, Rt on Beaver Rd, L on Journey's End, lot on right before end.

SUBDIVISION BLOCK / SECTION LOT LOT AREA SITE CLASS. V5 DESIGN FLOW 240 L.T.A.R. Ex

Septic Tank: Ex 1,000 Gallons; STB Date

Pump Tank: Gallons; PT Date

Pump Make: Model Serial No.

Nitrification Field: No Fields 1 Square Feet 600 Linear Feet Ex 200

No Lines 2 @ 100 Trench Width Max Trench Bottom Depth Gravel Depth 12"

☐ New System ☐ Repair System Type: I, II, III, IV, V, VI

System Description: Gravity Conv.

Repair System Description: —

Maintenance Agreement Required: ☐ Yes ☒ No

☐ House/Mod. Home ☒ Mobile Home ☐ Business ☐ Other

No. Bedrooms 2 No. Bathrooms No. Employees

☐ Slab ☒ Crawl Space ☐ Basement w/plumbing ☐ Basement wo/plumbing

Water Supply: ☒ Individual ☐ Public ☐ Community

Comments:/Conditions:


Comments:/Conditions:

- System okay at time of inspection
- Keep MH str off Septic Tank

(Reference: Terry DeHart 7/31/91)

INITIAL SITE SKETCH

AS BUILT SKETCH Not to Scale

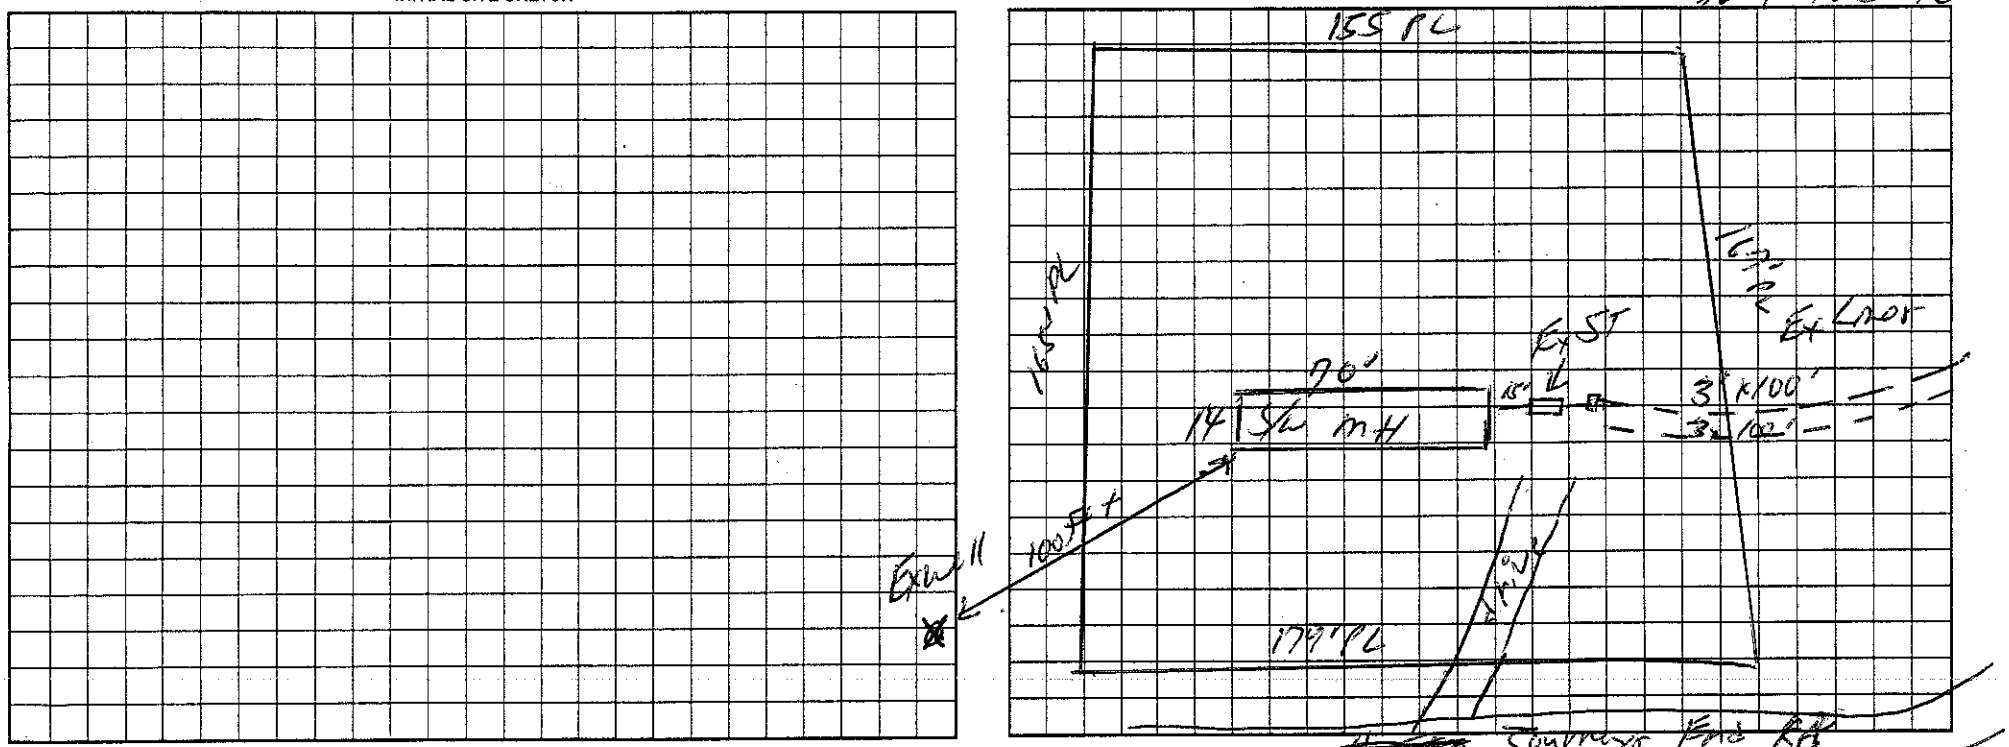


Permit can be suspended or revoked if any false information is supplied toward securing the permit/any unauthorized changes are made to the site/any unauthorized changes are made in the installation of the system. Improvement Permit with plat valid without expiration. Improvement Permit with site plan valid for sixty months. Authorization to Construct is valid for a period equal to that of Improvement Permit – not to exceed sixty months.

Signed: date

Improvement Permit by: date

Authorization to Construct by: date

Installed by:

Operation Permit by: date

Existing System Inspection by: William O. Johnson date 11/9/04

HEALTH DEPT. COPY: WHITE OWNER COPY (FINAL): YELLOW OWNER COPY (INITIAL): PINK