IREDELL COUNTY HEALTH DEPARTMENT

STATESVILLE 704-878-5305 MOORESVILLE 704-664-5281

IMPROVEMENT PERMIT / AUTHORIZATION TO CONSTRUCT / OPERATION PERMIT / EXISTING SYSTEM INSPECTION

PERMIT# 094822 PIN# 4765580950 DATE 2/23/01

OWNER OR CONTRACTOR Rivergreen LLC PHONE: Business (704) 609-7745 Home —

ADDRESS P.O. Box 1933 Lincolnton N.C. 28093

LOCATION Hwy 64 E @ RiverHill Road, @ Rivergreen, @ Sweetwater on left

SUBDIVISION Rivergreen BLOCK / SECTION — LOT 9 LOT AREA .58 Acres SITE CLASS. PS DESIGN FLOW 480 L.T.A.R. .3

Septic Tank: 1000 Gallons; STB 312 Date 1-14-01
Pump Tank: — Gallons; PT — Date —
Pump Make: — Model — Serial No —
Nitrification Field: No Fields 1 Square Feet 1600 Linear Feet 534
No Lines 6@89 Trench Width 36" Max Trench Bottom Depth 30" Gravel Depth 12"

[X] New System [ ] Repair System Type: I (II) III, IV, V, VI
System Description: Gravity Conventional
Repair System Description: Gravity, 50% Reduction
Maintenance Agreement Required: [ ] Yes [X] No
[ ] Slab [X] Crawl Space [ ] Basement w/plumbing [ ] Basement wo/plumbing


[ ] House/Mod. Home No. Bedrooms 4
[X] Mobile Home No. Bathrooms 2
[ ] Business No. Employees —
[ ] Other —

Water Supply: [ ] Individual [X] Public [ ] Community


Comments/Conditions: ① Do not install when wet ② Install lines on contour ③ Keep lines 10ft from Property Lines ④ Use one (1) Flow divider and (5) drop boxes

Comments/Conditions: SYSTEM INSTALLED AS SHOWN WITH POLYLOK FILTER, + MARKER

INITIAL SITE SKETCH 1"=60' Scale

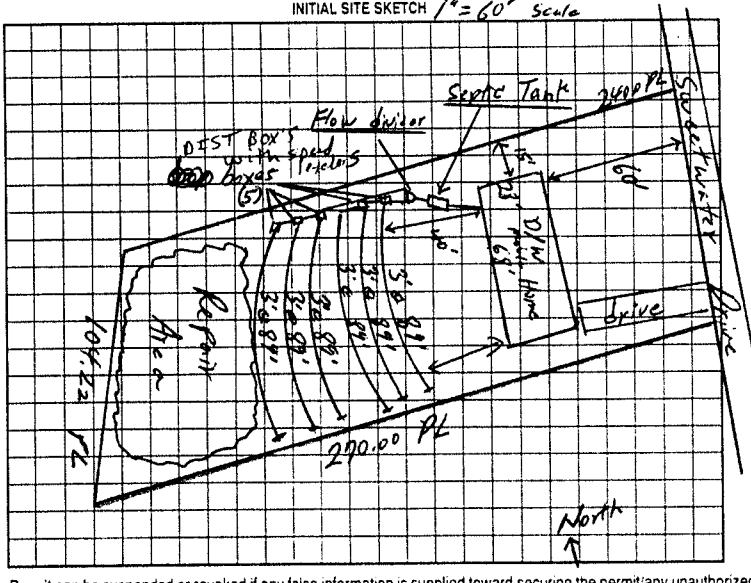

AS BUILT SKETCH

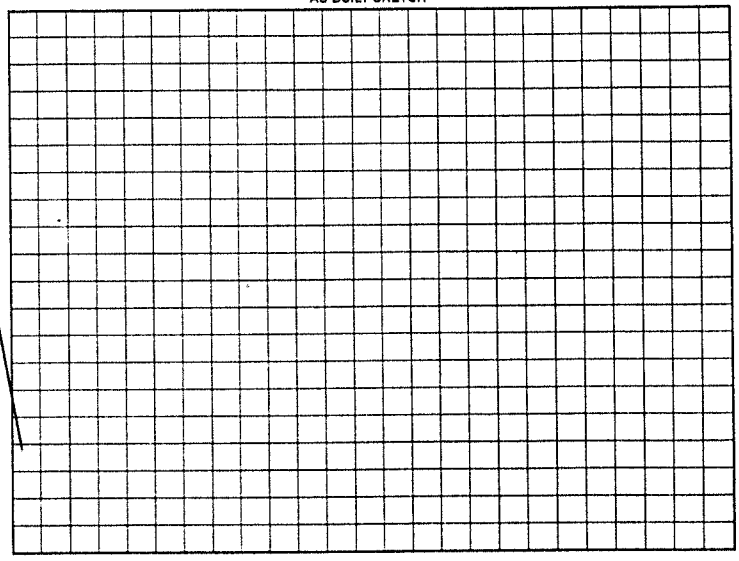

Permit can be suspended or revoked if any false information is supplied toward securing the permit/any unauthorized changes are made to the site/any unauthorized changes are made in the installation of the system. Improvement Permit with plat valid without expiration. Improvement Permit with site plan valid for sixty months. Authorization to Construct is valid for a period equal to that of Improvement Permit – not to exceed sixty months.

Signed: Steve Lyle date 2-23-01

Improvement Permit by: William O. Johnson RSI date 2/23/01

Authorization to Construct by: William O. Johnson RSI date 2/23/01

Installed by: Craig Thompson & Tommy Frye

Operation Permit by: Ken Cook RS date 5-15-01

Existing System Inspection by: — date —

HEALTH DEPT. COPY WHITE OWNER COPY (FINAL) YELLOW OWNER COPY (INITIAL) PINK