This permit voids previously issued permit dated 2/26/01.

IREDELL COUNTY HEALTH DEPARTMENT

STATESVILLE 704-878-5305 MOORESVILLE 704-664-5281

IMPROVEMENT PERMIT / AUTHORIZATION TO CONSTRUCT / OPERATION PERMIT / EXISTING SYSTEM INSPECTION

PERMIT# 094823 PIN# 4765 580950 DATE 4-3-01

OWNER OR CONTRACTOR River green LLC PHONE: Business (704) 609-2745 Home —

ADDRESS P.O. Box 1232 Lincolnton, NC 28093

LOCATION 64 E, ⓛ Riverhill Rd, ⓡ Rivergreen, ⓛ on Sweetwater at End on ⓡ

SUBDIVISION Rivergreen BLOCK / SECTION — LOT 10 LOT AREA .61 SITE CLASS PS DESIGN FLOW 360 L.T.A.R. .35

Septic Tank: 1,000 Gallons: STB 312 Date 1-14-01

Pump Tank: Gallons: PT Date

Pump Make: Model Serial No.

Nitrification Field: No Fields 1 Square Feet 1029 Linear Feet 344

No Lines 4@86 Trench Width 36" Max Trench Bottom Depth 30" Gravel Depth 12"

☒ New System ☐ Repair System Type: I (II) III IV V VI

System Description: Conventional, Gravity

Repair System Description: Soil Reduction, Gravity

Maintenance Agreement Required: ☐ Yes ☒ No

☐ House/Mod. Home ☒ Mobile Home ☐ Business ☐ Other

No. Bedrooms 3 No. Bathrooms 2 No. Employees


Water Supply: ☐ Individual ☒ Public ☐ Community

☐ Slab ☒ Crawl Space ☐ Basement w/plumbing ☐ Basement wo/plumbing

Comments/Conditions: ① Do Not install when wet ② Install lines on Contour ③ Keep System 10 Ft From Property lines

Comments/Conditions System installed as shown with poly/lok filter & marker

INITIAL SITE SKETCH

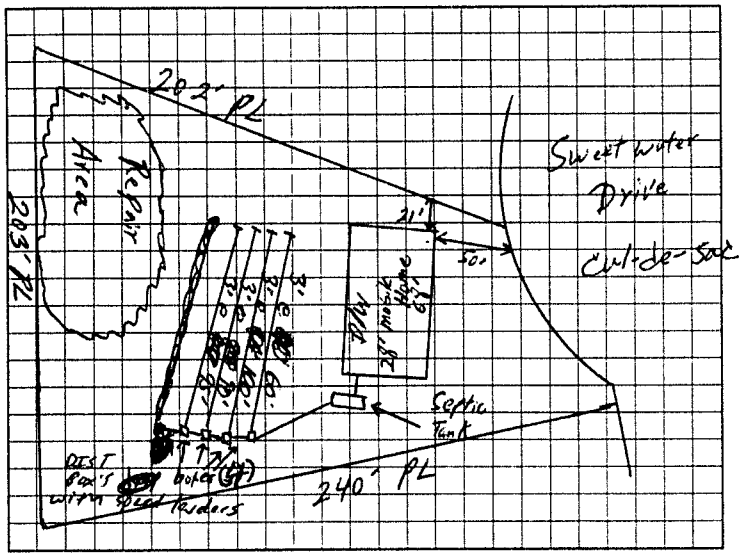

AS BUILT SKETCH

Permit can be suspended or revoked if any false information is supplied toward securing the permit/any unauthorized changes are made to the site/any unauthorized changes are made in the installation of the system. Improvement Permit with plat valid without expiration. Improvement Permit with site plan valid for sixty months. Authorization to Construct is valid for a period equal to that of Improvement Permit – not to exceed sixty months.

Signed: Daniel Queen date 4-3-01 Installed by: Craig T Rapso - Tommy Fox

Improvement Permit by: William O. Johnson RSI date 4-3-01 Operation Permit by: Jim Cook RSI date 5-15-01

Authorization to Construct by: William O. Johnson RSI date 4-3-01 Existing System Inspection by: date

HEALTH DEPT. COPY WHITE OWNER COPY (FINAL) YELLOW OWNER COPY (INITIAL) PINK