IREDELL COUNTY HEALTH DEPARTMENT

STATESVILLE 704-878-5305 MOORESVILLE 704-664-5281

IMPROVEMENT PERMIT / AUTHORIZATION TO CONSTRUCT / OPERATION PERMIT / EXISTING SYSTEM INSPECTION

PERMIT# 106872 PIN# 4765-49-8226 DATE 7-2-03

OWNER OR CONTRACTOR FLEETWOOD HOMES PHONE: Business 704-400-7019 Home

ADDRESS 1270 NORTH SIDE DR STATESVILLE, NC 28625

LOCATION (1) EAST, (2) RIVERHILL ROAD, (3) RIVERGREEN (4) SWEETWATER, ATTHD IN CUL-DE-SAC

SUBDIVISION RIVERGREEN BLOCK / SECTION ____ LOT 11 LOT AREA 0.64c SITE CLASS. PS DESIGN FLOW 360 L.T.A.R. .25

Septic Tank: 1000 Gallons; STB 1012 Date 3-21-03
Pump Tank: 1000 Gallons; PT 17 Date 6-3-03
Pump Make: ____ Model ____ Serial No. ____
Nitrification Field: No Fields 1 Square Feet ED=/440' Linear Feet 240'
No Lines 4 Trench Width 24" Max Trench Bottom Depth 36" Gravel Depth N/A

☒ New System ☐ Repair System Type: I, II, III, (IV), V, VI
System Description: LOW PRESS PAWEL
Repair System Description: SAME
Maintenance Agreement Required: ☒ Yes ☐ No


☐ House/Mod. Home ☒ Mobile Home ☐ Business ☐ Other
No. Bedrooms 3 No. Bathrooms 2 No. Employees ____
☐ Slab ☒ Crawl Space ☐ Basement w/plumbing ☐ Basement wo/plumbing

Water Supply: ☐ Individual ☒ Public ☐ Community

Comments:/Conditions: (1) PUT CULVERT UNDER DRIVE & CONNECT TO DITCH THAT RUNS DOWN SIDE OF DRIVEWAY (2) FILL PAD FOR D/W TO SET ON SO SETBACKS FOR TANKS CAN BE MAINTAINED,

Comments:/Conditions: (3) KEEP ALL SUPPLY LINES 5' OR GREATER OFF SIDE P/L, (4) PUT PIPE UNDER DRIVE SO POSITIVE DRAINAGE DITCH WILL EXIT TO THE DITCH ABOVE THE DRIVEWAY (5) SYSTEM & HOUSE IS COMPLETELY PLANNED OUT ON LOT, (6) CALL PRIOR TO INSTALLATION FOR PUMP SIZING. (7) CALL PRIOR TO ANY EXCAVATION FOR CONSULTATIVE VISIT

INITIAL SITE SKETCH 1"≈50'

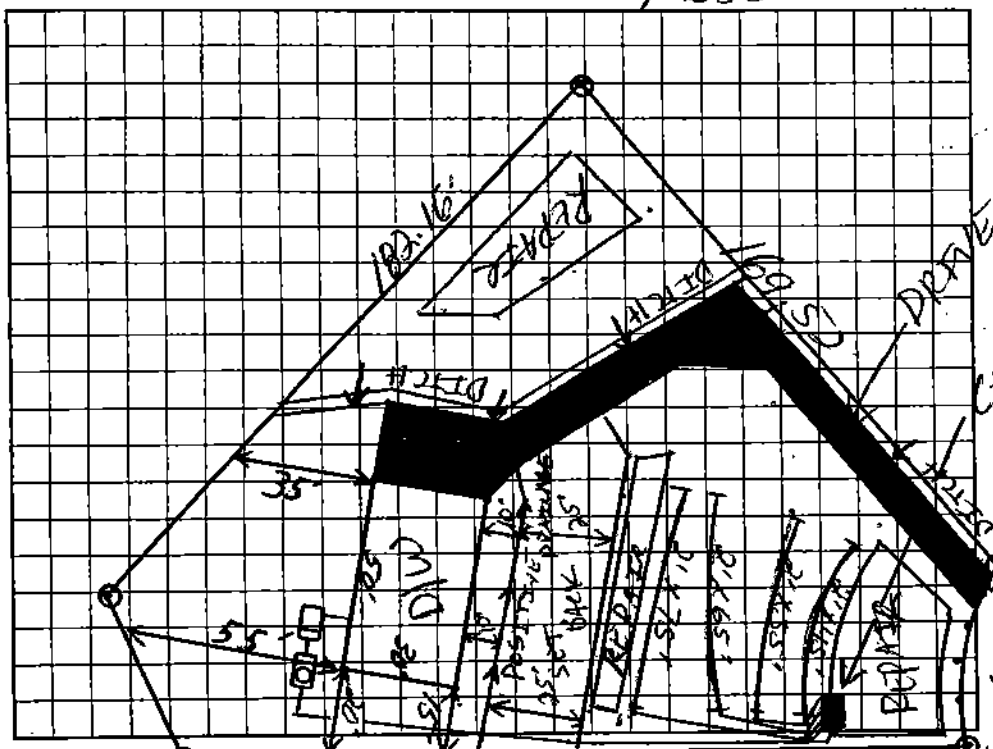

AS BUILT SKETCH

(1) SEPTIC TANK W/ MARKER INSTALLED
(2) SYSTEM INSTALLED & PRESSURE CHECKED ACCORDING TO INITIAL SITE SKETCH, 8-19-03 RSH

I.D.
54928

Permit can be suspended or revoked if any false information is supplied toward securing the permit/any unauthorized changes are made to the site/any unauthorized changes are made in the installation of the system. Improvement Permit with plat valid without expiration. Improvement Permit with site plan valid for sixty months. Authorization to Construct is valid for a period equal to that of Improvement Permit – not to exceed sixty months.

Signed: ____ date 7/10/03
Improvement Permit by: RS date 7-12-03
Authorization to Construct by: RS date 7-12-03

Installed by: CRAIG THOMPSON
Operation Permit by: STEVE HEDRICK date 8-27-03
Existing System Inspection by: ____ date ____

HEALTH DEPT. COPY: WHITE OWNER COPY (FINAL): YELLOW OWNER COPY (INITIAL): PINK