CI

IREDELL COUNTY HEALTH DEPARTMENT

STATESVILLE 704-878-5305 MOORESVILLE 704-664-5281

IMPROVEMENT PERMIT / AUTHORIZATION TO CONSTRUCT / OPERATION PERMIT / EXISTING SYSTEM INSPECTION

PERMIT# 104612 PIN# 4765-49-9372 DATE 05-04-02

OWNER OR CONTRACTOR FLEETWOOD HOMES PHONE: Business 704-872-6179 Home

ADDRESS 1270 NORTHSIDE DR STATESVILLE NC 28625

LOCATION 64E, ④ RIVER [redacted], ⑤ RIVERGREEN, ⑥ SWEETWATER, AT END IN CU-DE-SAC

SUBDIVISION RIVERGREEN BLOCK / SECTION LOT 12 LOT AREA 0.6 AC SITE CLASS DESIGN FLOW L.T.A.R.

Septic Tank: 1000 Gallons: STB 1012 Date 12-1-01
Pump Tank: 1000 Gallons: PT 17 Date 1-26-02
Pump Make: LITTLE GIANT Model 15428 Serial No PH1
Nitrification Field: No Fields 1 Square Feet 6.6x1200' Linear Feet 300'
No Lines 4+1=5x60' Trench Width 36" Max Trench Bottom Depth 36" Gravel Depth N/A

X New System ☐ Repair System Type: I, II, (III), IV, V, VI
System Description: PUMP 2504 RED
Repair System Description: LP PANEL
Maintenance Agreement Required: ☐ Yes ☐ No

☐ House/Mod. Home ☒ Mobile Home ☐ Business ☐ Other
No. Bedrooms 3 No. Bathrooms 2 No. Employees

☐ Slab ☒ Crawl Space ☐ Basement w/plumbing ☐ Basement wo/plumbing


Water Supply: ☐ Individual ☒ Public ☐ Community

Comments/Conditions: ① SYSTEM IS FLAGGED OUT ② INSTALL LINES ON CONTOURS ③ SHARP CURVE SO HDS SECTIONS MAY BE MORE SUITABLE THAN CHAMBERS, IF USE CHAMBERS MUST USE CONTOUR BENDS; ④ MAINTAIN SETBACKS

Comments/Conditions: ⑤ FILL PAD AREA — DO NOT CUT! IF CUT PERMIT WILL BE VOID & POSSIBLE LOW PRESSURE SYSTEM WILL HAVE TO BE DESIGNED ⑥ CALL PRIOR TO INSTALLATION FOR PUMP SIZING

INITIAL SITE SKETCH

1" = 50'

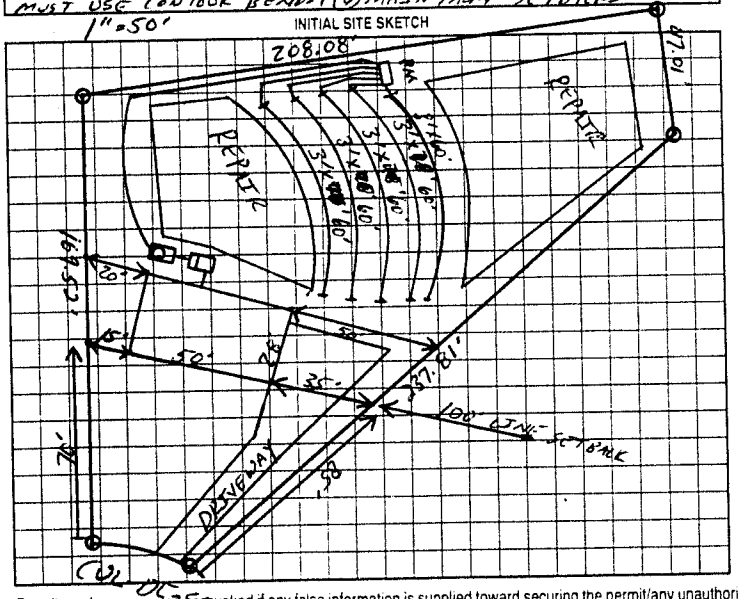

AS BUILT SKETCH

SYSTEM WAS FLAGGED OUT INSTALLED OUT OF CONTOUR CHANGED TO 5 LINES 60' LONG & THAT WAS BACK IN CONTOUR!

V'D LINES & TANKS.
NEEDS ELECTRICAL, PRESSURE, & PUMP INFO.

PUMP WIRED TO OUTSIDE PANEL RECEPTACLE BOX & ALARM WIRED TO INSIDE RECEPTACLE

Permit can be suspended or revoked if any false information is supplied toward securing the permit/any unauthorized changes are made to the site/any unauthorized changes are made in the installation of the system. Improvement Permit with plat valid without expiration. Improvement Permit with site plan valid for sixty months. Authorization to Construct is valid for a period equal to that of Improvement Permit – not to exceed sixty months.

Signed: date 3-11-02 Installed by: CRAIG THOMPSON

Improvement Permit by: RS date 03-04-02 Operation Permit by: RS date 05-08-02

Authorization to Construct by: RS date 03-04-02 Existing System Inspection by: date

HEALTH DEPT. COPY. WHITE OWNER COPY (FINAL) YELLOW OWNER COPY (INITIAL). PINK