IREDELL COUNTY HEALTH DEPARTMENT - *ENVIRONMENTAL HEALTH* ☐ STATESVILLE OFFICE 704-878-5305 ☐ MOORESVILLE OFFICE 704-664-5281

IMPROVEMENT PERMIT / AUTHORIZATION TO CONSTRUCT / OPERATION PERMIT / EXISTING SYSTEM INSPECTION

PERMIT # REPAIR PIN # 4765-51-1315 DATE MAY 18 2012

OWNER TIM TAYLOR APPLICANT: SAME PHONE: Home/Cell # 541-324-0555 Business #

SITE ADDRESS 199 BELL FARM ROAD OWNER / APPLICANT ADDRESS 199 BELL FARM ROAD, STATESVILLE 28625

SITE DIRECTIONS US 64 EAST, TR BELL FARM ROAD, ON LEFT AT #199, 300' BACK off ROAD

SUBDIVISION CEDAR CREEK BLOCK / SECTION N/A LOT # 1 LOT AREA 1.67 ACRES DESIGN FLOW 720 L.T.A.R. 0.25 GPD/FT²

Septic Tank 1500 Gallons: STB 1014 Date 11-25-11
Pump Tank ____ Gallons: P T ____ Date ____
Pump Make ____ Model ____ Serial # ____
No. Nitrification Fields: 1 No. Lines 5 Linear Feet 720
Trench Width 36" Max. Trench Bottom Depth 36" Gravel Depth N/A


☐ New System ☑ Repair ☐ Expansion System Type I II (III) IV V VI
System Description: ____
Repair System Description: 25% REDUCTION, GRAVITY
Maintenance Agreement Required ☐ YES ☑ NO
☑ GRAVITY ☐ PRESSURE

☑ Residence No. Bedrooms 5
☐ Business No. Persons 4 + CAMPER
☐ Other No. Employees PAID
☑ Slab ☑ Crawl Space
☐ Basement w/plumbing ☐ Basement w/o plumbing


Water Supply: ☑ Private WELL ☐ Public ☐ Community

Comments / Conditions: ① INSTALL NEW 1500 GAL. SEPTIC TANK AT LOCATION SHOWN ② INSTALL NEW 25% REDUCTION SYSTEM ON CONTOUR AS SHOWN USING SERIAL DISTRIBUTION. ③ SIZED FOR 1-3BR HOUSE 1-2BR HOUSE & 1 TEMP. CAMPER

INITIAL SITE SKETCH

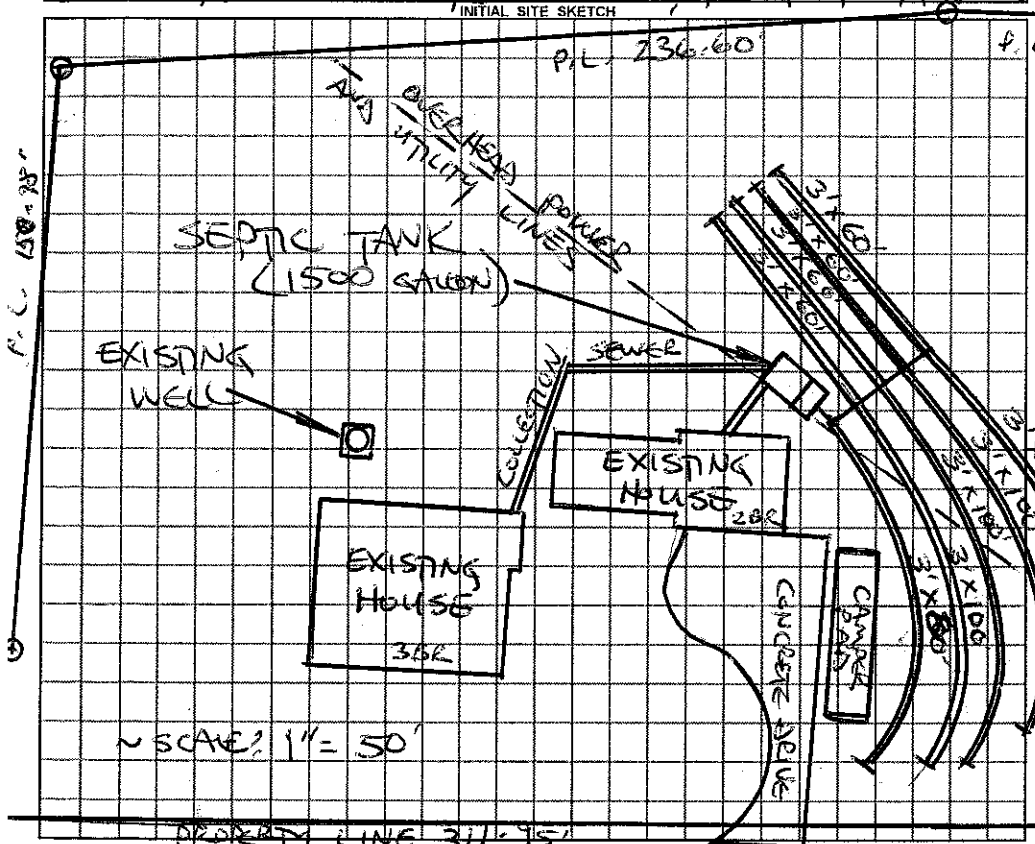

AS BUILT SKETCH

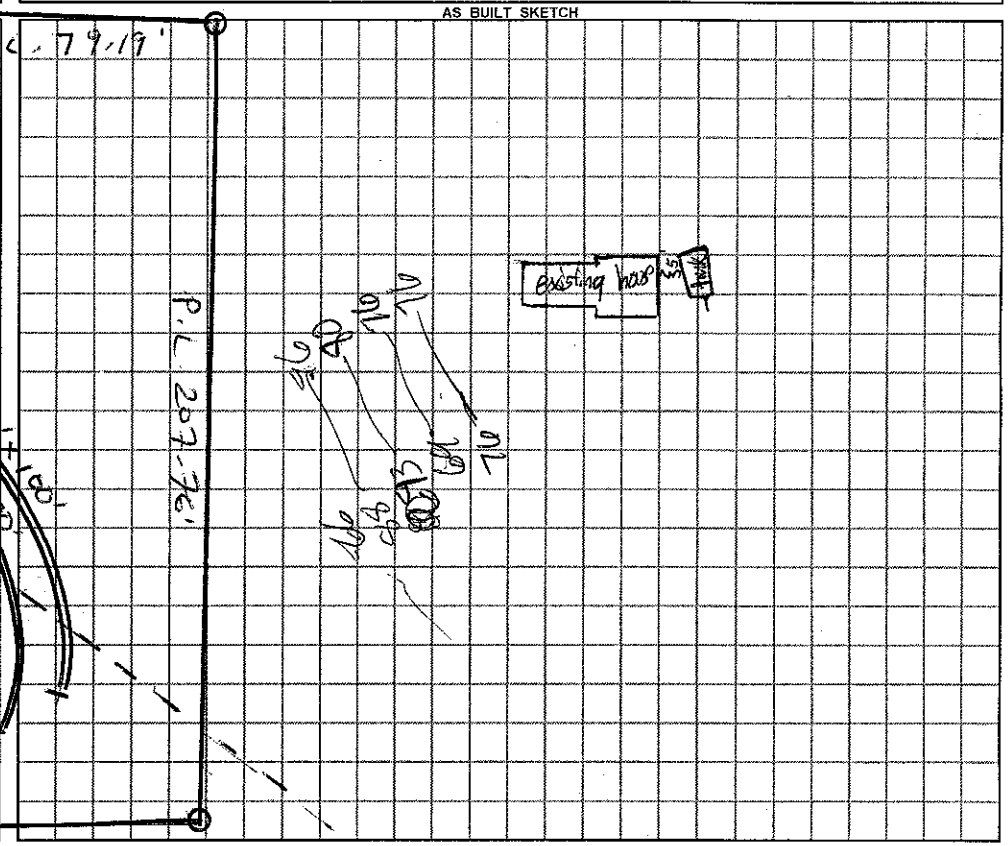

Permit can be suspended or revoked if any false information is supplied toward securing the permit / any unauthorized changes are made to the site / any unauthorized changes are made in the installation of the system.

☐ ***IMPROVEMENT PERMIT*** with plat valid without expiration. ☑ ***IMPROVEMENT PERMIT*** with plat valid without expiration. Site plan valid 60 mo. ☐ ***AUTHORIZATION TO CONSTRUCT*** valid for period equal to IMPROVEMENT PERMIT--not to exceed 60 mo.

Owner / Applicant Signature: Tim Taylor Date 5-22-12 Installed by: Piedmont Septic Tank

IMPROVEMENT PERMIT by: STEVE HENDRICK REHS Date 5-18-12 OPERATION PERMIT by: James REHS Date 6-21-12

AUTHORIZATION TO CONSTRUCT by: STEVE HENDRICK REHS Date 5-18-12 Existing System Inspected by: ____ REHS Date ____

YOU SHOULD CONTACT A LOCATOR SERVICE PRIOR TO ANY EXCAVATION

White Copy – Environmental Health YELLOW COPY (Final) Owner / Applicant PINK COPY (Initial) Owner / Applicant