IREDELL COUNTY HEALTH DEPARTMENT

STATESVILLE 704-878-5305 MOORESVILLE 704-664-5281

IMPROVEMENT PERMIT / AUTHORIZATION TO CONSTRUCT / OPERATION PERMIT / EXISTING SYSTEM INSPECTION

PERMIT # Relocation PIN # 4765-51-5912 DATE 1 September 10

OWNER or APPLICANT Caldwell Bunker, Inc. PHONE: Business (704) 902-2852 Home:

OWNER or APPLICANT ADDRESS 132 Sweetgum Ln, Statesville

LOCATION / DIRECTIONS Hwy 64E TR Bell Farm Rd. TL Maplewood TR Birchwood Ln. TL Sweetgum - on Rt.

SUBDIVISION Cedar Hill BLOCK / SECTION LOT # 48 LOT AREA DESIGN FLOW L.T.A.R.

New

Septic Tank 1000 Gallons: STB 760 Date 5-22-10

Pump Tank Gallons: P T Date

Pump Make Model Serial #

Nitrification Field No Fields 1 No Lines Linear Feet

Exist Trench Width Max. Trench Bottom Depth Gravel Depth

☑ New System ☐ Repair ☐ Expansion System Type I II III IV V VI

System Description: Conventional bed

Repair System Description:

Maintenance Agreement Required ☐ YES ☑ NO

☑ GRAVITY ☐ PRESSURE

☑ Residence No. Bedrooms 3

☐ Business No. Persons

☐ Other No. Employees

☐ Slab ☐ Crawl Space


☑ Basement w/plumbing ☐ Basement w/o plumbing

Water Supply: ☐ Private ☑ Public ☐ Community


Comments / Conditions: Property Abandon existing ST. Replace with new 1000g ST.

Comments / Conditions

INITIAL SITE SKETCH

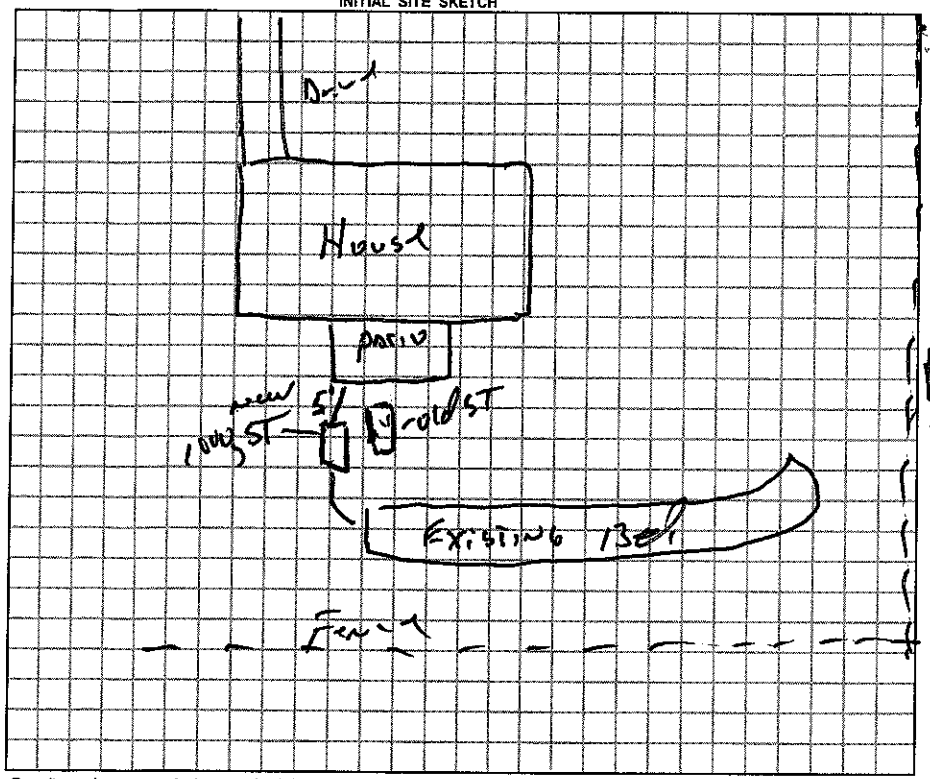

AS BUILT SKETCH

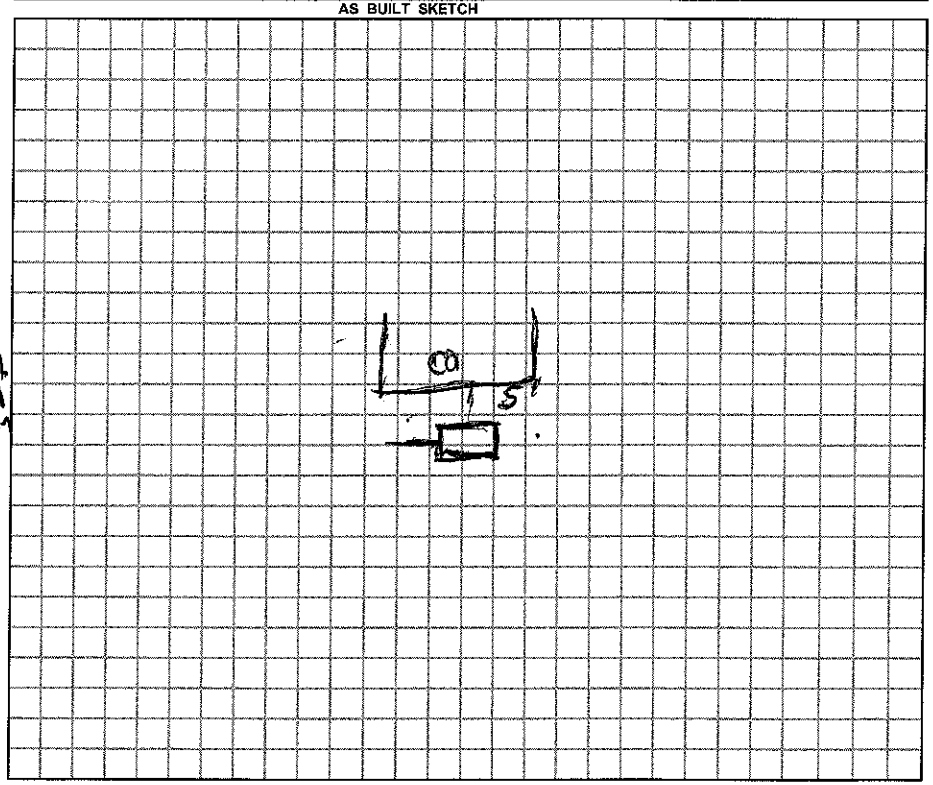

Permit can be suspended or revoked if any false information is supplied toward securing the permit / any unauthorized changes are made to the site / any unauthorized changes are made in the installation of the system.

☐ *IMPROVEMENT PERMIT w / plat valid without expiration.* ☑ *IMPROVEMENT PERMIT w / site plan valid for 60 mos.* ☑ *AUTHORIZATION TO CONSTRUCT valid for period equal to IMPROVEMENT PERMIT-not to exceed 60 mo.*

Owner / Applicant Signature: Date

Improvement Permit by: R.S Date 1 Sept. 10

Authorization to Construct by: R.S Date 1 Sept. 10

Installed by: Gunter Grading

Operation Permit by: Date: 9-7-10

Existing System Inspected by: Date:

YOU SHOULD CONTACT A LOCATOR SERVICE PRIOR TO ANY EXCAVATION.

WHITE COPY Environmental Health YELLOW COPY (Final) Owner / Applicant PINK COPY (Initial) Owner / Applicant