IREDELL COUNTY HEALTH DEPARTMENT

STATESVILLE 704-878-5305 MOORESVILLE 704-664-5281

IMPROVEMENT PERMIT / AUTHORIZATION TO CONSTRUCT / OPERATION PERMIT / EXISTING SYSTEM INSPECTION

PERMIT# REPAIR PIN# 4765-51-6811 DATE 7-14-09

OWNER OR CONTRACTOR WADE E. & RACHEL KNOX PHONE: Business Home 704-880-3586

ADDRESS 136 SWEET GUM LANE, STATESVILLE, NC 28625

LOCATION US 64 EAST, TR BELL FARM RD, TL MAPLEBAF, TR BIRCHWOOD, TL SWEET GUM LANE, 6th LOT ON RIGHT

SUBDIVISION CEDAR HILLS BLOCK / SECTION LOT 47 LOT AREA LIMITED SITE CLASS. P3 DESIGN FLOW 480 L.T.A.R.

Septic Tank: EXISTING Gallons: STB Date

Pump Tank: Gallons: PT Date

Pump Make: Model Serial No.

Nitrification Field: No Fields 1 Square Feet 360 Linear Feet 120

No Lines TWO Trench Width 36" Max Trench Bottom Depth 36" Gravel Depth 18"

☐ New System ☑ Repair System Type: I, II, III, IV, V, VI

System Description: CONVENTIONAL, GRAVITY

Repair System Description: CONVENTIONAL, GRAVITY

Maintenance Agreement Required: ☐ Yes ☑ No

☑ House/Mod. Home No. Bedrooms 4

☐ Mobile Home No. Bathrooms 2½

☐ Business No. Employees

☐ Other


☐ Slab ☐ Crawl Space ☑ Basement w/plumbing ☐ Basement wo/plumbing

Water Supply: ☐ Individual ☑ Public ☐ Community

Comments:/Conditions: INTERCEPT EXISTING DRAINLINE BY INSTALLING NEW DROP BOX AT LOCATION SHOWN FEEDING TWO NEW 3' x 60' LINES USING 18" STONE. SYSTEM TO BE REPAIRED BY 8-13-04.

Comments:/Conditions: NOTICE OF VIOLATION ISSUED 7-13-04

INITIAL SITE SKETCH

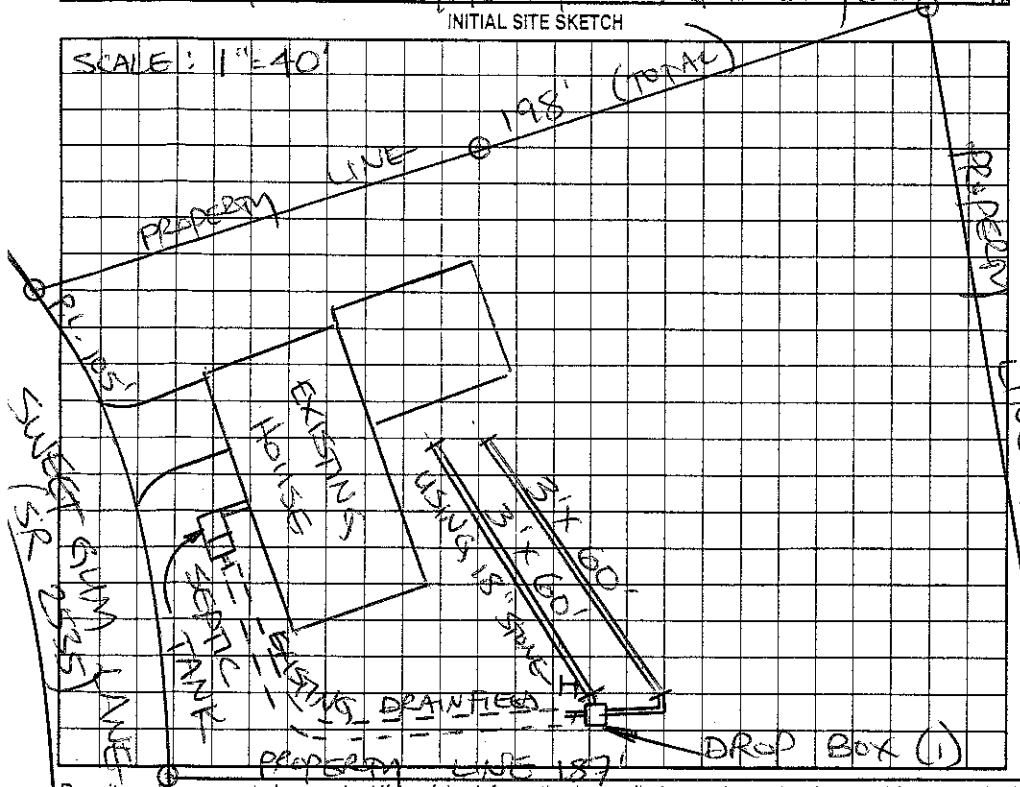

AS BUILT SKETCH

SYSTEM REPAIRED ACCORDING TO INITIAL SITE SKETCH

Permit can be suspended or revoked if any false information is supplied toward securing the permit/any unauthorized changes are made to the site/any unauthorized changes are made in the installation of the system. Improvement Permit with plat valid without expiration. Improvement Permit with site plan valid for sixty months. Authorization to Construct is valid for a period equal to that of Improvement Permit – not to exceed sixty months.

Signed: date 7/14/09 Installed by: FOREST SHUFORD

Improvement Permit by: STEVE HENDRICK date 7-14-04 Operation Permit by: STEVE HENDRICK date 8-6-04

Authorization to Construct by: STEVE HENDRICK date 7-14-09 Existing System Inspection by: date

HEALTH DEPT. COPY: WHITE OWNER COPY (FINAL): YELLOW OWNER COPY (INITIAL): PINK