# ICHD - ENVIRONMENTAL HEALTH DIVISION

Statesville Office (704) 878-5305 Mooresville Office (704) 660-3625 PERMIT # 310178

## SEPTIC: IMPROVEMENT PERMIT / AUTHORIZATION TO CONSTRUCT / OPERATION PERMIT / EXISTING SYSTEM

PIN # 4765-52-4268

APPLICANT/OWNER: Debra Bellamy
APPLICANT ADDRESS: 112 Sweetgum Ln, Statesville
SITE ADDRESS: 112 Sweetgum Ln, Statesville 28625
PHONE: 704-873-0110 ALT. PHONE —
SITE DIRECTIONS: Ley → R Bell Farm → L Mapleleaf → R Birchwood → L Sweetgum → on R
SAP CONTROLLED: ☐ YES ext ☐ NO
SUBDIVISION: Cedar Hills
SECTION: — LOT # 51 LOT AREA:
DESIGN FLOW: ext L.T.A.R.: ext


| | | | | | | | | | |
|---|---|---|---|---|---|---|---|---|---|
| Septic Tank | 1000 (gal) | STB 2071 | Date INFILTRATOR | ☐ New System | ☑ Repair | ☐ Expansion | System Type: I (II) III IV V VI | ☑ Residence | No. Bedrooms ext |
| Pump Tank | (gal) | PT | Date | System Description: — | | | | ☐ Business | No. Persons ext |
| Pump Make | Model | | Serial # | Repair System Description: Tank | | | | ☐ Other | No. Employees |
| # Nitrification Fields | # Lines | | Linear Ft: | Maintenance Agreement Required: | ☐ YES | ☑ NO | | ☑ Slab | ☑ Crawl Space |
| Trench Width | Trench Bottom Depth (Low side) | | Gravel Depth ext | | ☑ GRAVITY | ☐ PRESSURE | | ☐ Basement w/ plumbing | ☐ Basement w/o plumbing |

EXISTING

**Water Supply**: ☐ Private ☑ Public ☐ Community

Comments / Conditions: Pump, crush & fill existing cracked tank. Inspect & replace d-box if needed. Maintain 10' from house if possible, must maintain 5'.

INITIAL SITE SKETCH

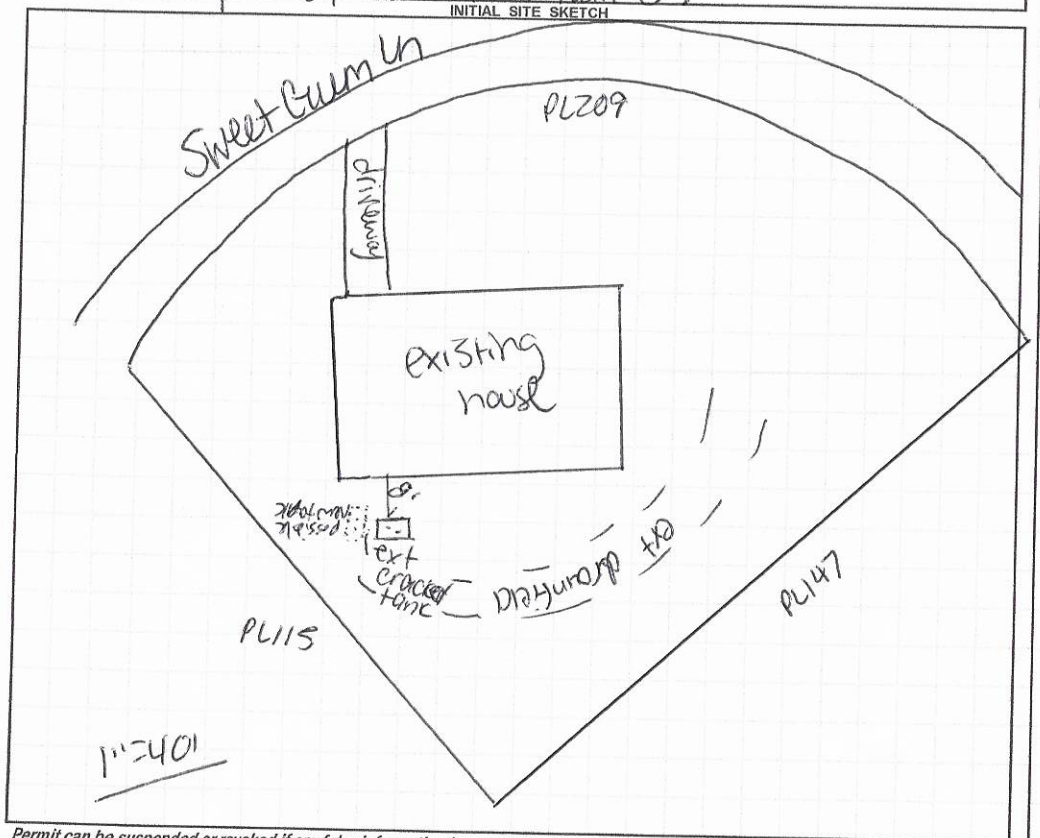


AS BUILT SKETCH

**FOR SEPTIC FINAL INSPECTION CALL: 704-664-3703 between 8am-9am the day the inspection is needed. Be sure to speak with an inspector to confirm your time.**

*Permit can be suspended or revoked if any false information is supplied toward securing the permit / any unauthorized changes are made to the site / any unauthorized changes are made in the installation of the system.* **CONTACT A LOCATOR SERVICE PRIOR TO ANY EXCAVATION**

☐ **IMPROVEMENT PERMIT** *with plat valid without expiration.* ☑ **IMPROVEMENT PERMIT** *with site plan valid for 60 mos.* ☑ **AUTHORIZATION TO CONSTRUCT** *valid for period equal to IMPROVEMENT PERMIT--not to exceed 60 mo.*

Owner / Applicant Signature: Debra Bellamy Date: 8-31-20
Installed by: ANDY YOUNTZ
IMPROVEMENT PERMIT by: Carla G Nicks Date: 8-19-20
OPERATION PERMIT by: Barbara C. White Date: 9-4-2020
AUTHORIZATION TO CONSTRUCT by: Carla G Nicks Date: 8-19-20
Existing System Inspected by: Date:

**FOR SEPTIC FINAL INSPECTION: CALL 704-664-3703 between 8am-9am the day the inspection is needed.**

RECEIVED AUG 1 8 2020

**APPLICATION MUST BE FILLED OUT COMPLETELY & BE LEGIBLE OR IT WILL NOT BE PROCESSED**

Repair Evaluation - No Chg

# Iredell County Health Department – Environmental Health Division

**PAGE 1: *APPLICATION FORM***

AP- 310178

**Application For:**
( ) New Well Permit ( ) Well Repair Permit ( ) Well Abandonment
(✓) Septic Improvement Permit ( ) Authorization to Construct ( ) Existing System Inspection (✓) Septic System Repair

*THE ABOVE PERMIT DOCUMENTS WILL BECOME INVALID IF INFORMATION PROVIDED ON THIS APPLICATION IS FALSIFIED OR CHANGED, OR IF THE SITE IS ALTERED. THE IMPROVEMENT PERMIT IS VALID FOR EITHER 60 MONTHS OR WITHOUT EXPIRATION DEPENDING UPON DOCUMENTATION SUBMITTED. APPLICATION WITH SITE PLAN 60 MONTHS, APPLICATION WITH COMPLETE, SCALED PLAT WITHOUT EXPIRATION. SEE 15A NCAC 18A .1937(f) FOR DETAILS.*

**Page 2: *Site Plan Worksheet* form MUST accompany this application**

The following optional attachments may also be submitted: ( ) Survey Plat, scaled no more than 1 inch = 60 feet
*Place an (X) beside whichever is submitted if applicable* ( ) Custom Site Plan, scaled no more than 1 inch = 60 feet

**Applicant Information:** (PRINT CLEARLY)

Applicant Name: Debra Bellamy Address: 112 Sweetgum Ln. Zip: 28625
Applicant Email: dbellamy2013@yahoo.com Phone: 704 873-0110 Alt. Phone: 704 495-0877
Owner Name: Debra Bellamy Address: 112 Sweetgum Lane Zip: 28625
Owner Email: dbellamy2013@yahoo.com Phone: 704 873 0110 Alt. Phone: 704 495-0877

**Property Information:**

Street Address: 112 Sweetgum Lane
Subdivision Name: Cedar Hills Place Section/Phase: _____ Lot Number: 51
Driving Directions: turn L Center St. take 40 E. exit Davie hosp. turn L take 64 turn right Bell Farm 1000 ft take right Mapleleaf immediate left Birchwood righ sweetgum 2nd house on right

**Site Development Information:** *(check or complete ALL that apply)*

( ) New Single Family Residence
( ) New Multi-Family Residence
( ) Accessory Building
( ) Bedroom(s) Addition
( ) Repair to failing septic system ✓ Tank ___ Drain lines Describe Problem: Tank cracked

Maximum Number of Bedrooms: _____
Maximum Number of Occupants: _____
( ) Swimming Pool
( ) Other Addition/Structure: _____

**CHECK FOUNDATION TYPE**
( ) Crawl Space Foundation
(✓) Concrete Slab Foundation
( ) Basement with Plumbing
( ) Basement without Plumbing

**Non-Residential Site Development:** Type of Business: _____
Square Footage of Building: _____ Max. Number of Employees: _____ Max. Number of Seats/Beds/Other: _____

**Water Supply:** ( ) Replacement Well – Reason: _____
( ) Multi-connection Well Number of Houses: _____ Number of Persons: _____
( ) New Well ( ) Existing Well ( ) Community Well ( ) City Water (✓) Other Public Water Iredell Water

**Desired Septic System Type:** *(you may rank in order of preference)* Year existing system installed: _____
( ) No Preference ( ) Alternative ( ) Conventional ( ) Innovative ( ) Modified Conventional ( ) Other: _____

**Please answer the following to the best of your ability:**
( ) Yes (✓) No Does the site contain any jurisdictional wetlands?
( ) Yes (✓) No Is any non-domestic sewage (i.e. industrial) to be generated?
( ) Yes (✓) No Is the site subject to approval by any other public agency?

*I have read this application and certify that the information provided herein is true, complete, and correct. Authorized county and state officials are granted right of entry to conduct necessary inspections to determine compliance with applicable laws and rules. I understand that I am solely responsible for the proper identification and labeling of all property lines and corners and making the site accessible so that a complete site evaluation can be performed.*


**Signature:** Debra Bellamy May 28, 2020
Property owner or owner's legal representative signature (SIGNATURE REQUIRED) DATE

# IREDELL COUNTY HEALTH DEPARTMENT

## *ENVIRONMENTAL HEALTH DIVISION*

**PAGE 2: *SITE PLAN WORKSHEET***

**SEE THE "SAMPLE SITE PLAN" BELOW. *INCOMPLETE SITE PLANS WILL BE RETURNED TO YOU FOR COMPLETION AND MAY RESULT IN A DELAY IN THE ISSUANCE OF YOUR SEPTIC SYSTEM PERMIT!!!***

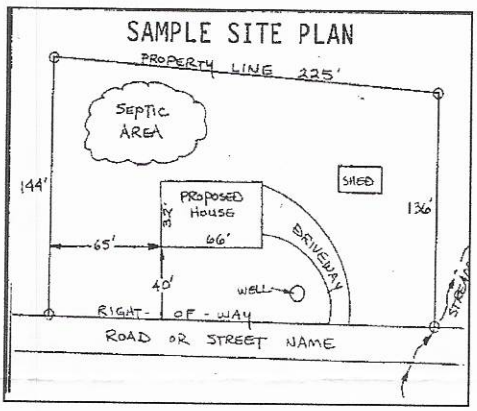


**Place an (X) beside each item as you complete the site plan:**


- ( ) Property Line measurements are clearly identified
- ( ) All proposed structures are indicated
- ( ) Front and side setbacks from property line
- ( ) Preferred driveway location and well location
- ( ) Area you prefer your septic system to be placed
- ( ) North arrow, or other sufficient indicator of direction

**Circle N/A on the following if appropriate:**

| | |
|---|---|
| Location of septic systems and wells within 100' of your property | N/A |
| Location of easements and rights of ways on your property | N/A |
| Location of any designated wetlands on the property | N/A |

## USE THIS SPACE TO DRAW YOUR SITE PLAN

*Show: proposed house or business footprint, wells, water lines, patios, pools and decks, and any other item that will occupy space on the site*

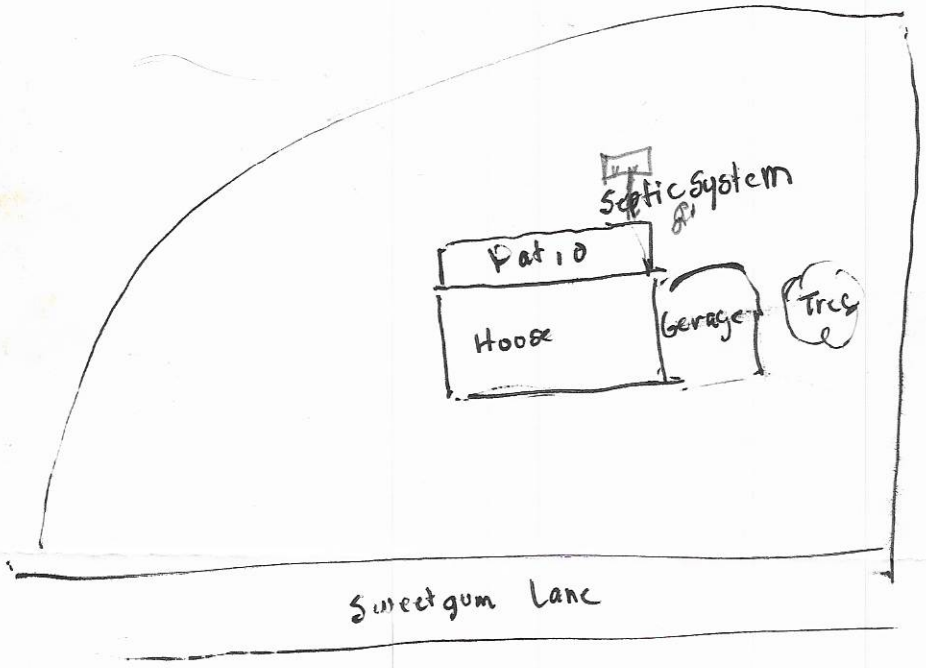


**Signature:** Debra Bellamy

Property owner or owner's legal representative signature (SIGNATURE REQUIRED)

May 28, 2020

DATE

## IREDELL COUNTY HEALTH DEPARTMENT

### (SEPTIC TANK) IMPROVEMENTS PERMIT AND CERTIFICATE OF COMPLETION
(Ground Absorption Sewage Disposal System -- G. S. Chapter 130-Article 13C)

OWNER OR CONTRACTOR Foster Enterprises DATE 3 Nov 76 PERMIT NO. _____

PHONE: Business _____ Home _____

LOCATION Hy 64 E to Bell Rd

S. R. No. _____


SUBDIVISION NAME Cedar Hills LOT NO. 451 SECTION OR BLOCK NO. _____

House (✓) Mobile Home ( ) Business ( ) Other _____

No. Bedrooms 3 No. Bathrooms 1½

| | | | | | |
|---|---|---|---|---|---|
| Garbage Disposal Unit | Yes ( ) | No (✓) | Character & Porosity of Soil | Cc O3 |
| Auto. Dishwasher | Yes ( ) | No (✓) | Percolation Rate | Very Slow |
| Auto. Wash. Machine | Yes (✓) | No ( ) | Topography | 10-15% Slope |
| Site Suitable | Yes (✓) | No ( ) | Depth to Water Table | 2' |
| | | | Rock or other impervious formations | NE |

Lot Area _____

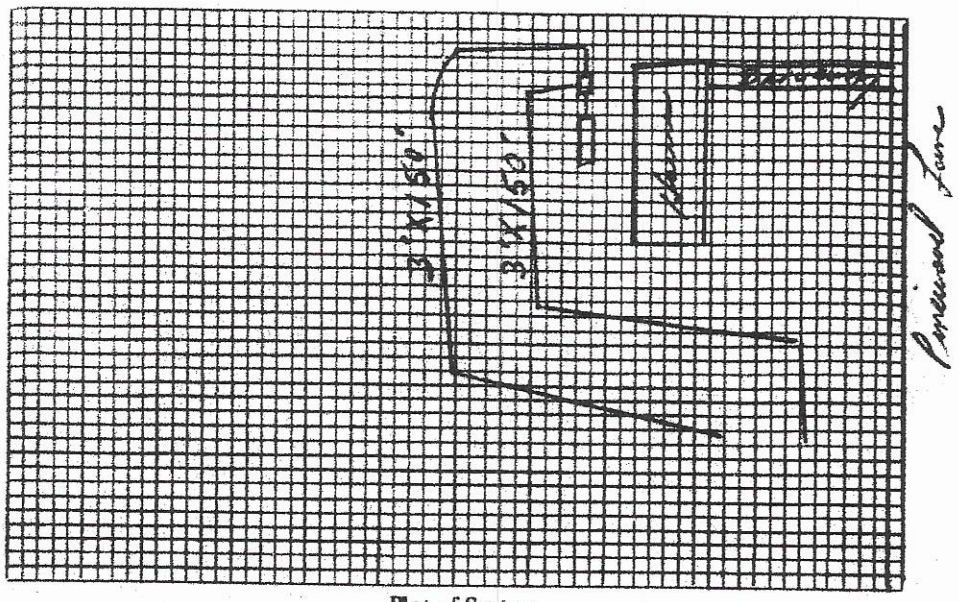


Plot of System

Size of Tank 1000 Gals.

Nitrification Field:
No. of Lines 2
Sq. Ft. 500 Linear Ft. 300
Depth of Stone in Lines 16"

Water Supply: Individual ( )
Public (✓)

Installed by Charlie Poff

IMPROVEMENTS PERMIT BY _____

COMMENTS: _____

CERTIFICATE OF COMPLETION BY Wm Toland DATE 2 Nov 76

CONSTRUCTION MUST COMPLY WITH ALL OTHER APPLICABLE STATE AND LOCAL REGULATIONS.

Health Dept. Copy: White Inspection Dept. Copy: Yellow Sanitarian's Copy: Pink Owner's Copy: Gold

IREDELL COUNTY DEPARTMENT OF ENVIRONMENTAL HEALTH

## DOCUMENTATION TO AUTHORIZE AN OWNER'S LEGAL REPRESENTATIVE

*(Check and sign only ONE of the options below)*

☐ **1. * APPLICANT AND OWNER ARE THE SAME. *** (*Sign here*) Debra Bellamy

Applications for permits require the "signature of the owner or owner's legal representative" (15A NCAC 18A .1937). If the owner does not sign the application himself or herself, they can submit any one of the following documents to designate their legal representative: *Power of Attorney; Real Estate Contract; Estate executor; Bankruptcy trustee; Court ordered guardianship*
In the absence of the above documentation, the property owner may provide the local health department with documentation that designates a legal representative. A property owner may:
Complete this form to document his or her legal representative, or provide his or her own form that contains the information in this form. If there are multiple property owners, then all property owners must sign the form that designates a legal representative.
**By signing a form that designates a legal representative for purposes of 15A NCAC 18A .1937, the property owner authorizes that representative to act on their behalf in matters pertaining to the application and permitting process, including signing or receiving any application, document or permit. The owner retains full responsibility to meet all permit conditions specified by the local health department.**

☐ **2.** I, Debra Bellamy, am the legal owner(s) of the property located at 112 Sweetgum Lane, identified as PIN (Parcel Identification Number)_____, located in Iredell County, North Carolina.

I do hereby authorize (**print legal representative/company name**) _____, _____, to act as an agent on my behalf in applying for/signing/obtaining any of the documents described below.

- Application for Improvement Permit (IP) / Authorization to Construct (AC)
- Improvement Permit (IP) / Authorization to Construct (AC)
- Application for soil-site evaluation (new/repair)
- Application/permit for private drinking water well/well abandonment
- Application for Compliance Inspection

I agree to abide by all decisions and/or conditions between the legal representative acting on my behalf and the Iredell County Department of Public Health, Environmental Health Division.

Debra Bellamy
Signature of Owner(s)

May 28, 2020
Date

**Mooresville - Environmental Health**
Fax: 704-662-3239
610 E. Center Avenue, Mooresville, NC 28115

**Statesville - Environmental Health**
ronda.hart@co.iredell.nc.us
Fax: 704-871-3483
349 N. Center Street, Statesville, NC 28677