**IREDELL COUNTY HEALTH DEPARTMENT - *ENVIRONMENTAL HEALTH*** ☒ STATESVILLE OFFICE 704-878-5305 ☐ MOORESVILLE OFFICE 704-664-5281

**IMPROVEMENT PERMIT / AUTHORIZATION TO CONSTRUCT / OPERATION PERMIT / EXISTING SYSTEM INSPECTION**

PERMIT # 163759 PIN # 4765-52-8143 DATE 10-21-10

OWNER John C Allen APPLICANT: John C Allen PHONE: Home/Cell # 704-682-8775 Business #

SITE ADDRESS 110 Redwood Ln OWNER / APPLICANT ADDRESS 404 Third Creek Church Road

SITE DIRECTIONS Bell Farm to Evergreen Wood (L) on Birchwood (R) on Redwood

SUBDIVISION Cedar Hills BLOCK / SECTION LOT # 93 LOT AREA .45 DESIGN FLOW 360 L.T.A.R. .3

Septic Tank 1000 Gallons: STB Date

Pump Tank Gallons: P T Date

Pump Make Model Serial #

No. Nitrification Fields: 1 No. Lines 2 Linear Feet 300

Trench Width 36" Max. Trench Bottom Depth 36" Gravel Depth n/a

☐ New System ☐ Repair ☒ Expansion System Type I II (III) IV V VI

System Description: 25% Reduction Gravity Relocation

Repair System Description: 50% Reduction LP

Maintenance Agreement Required ☐ YES ☒ NO

☒ GRAVITY ☐ PRESSURE

☒ Residence No. Bedrooms 3

☐ Business No. Persons

☐ Other No. Employees


☐ Slab ☒ Crawl Space

☐ Basement w/plumbing ☐ Basement w/o plumbing


Water Supply: ☐ Private ☒ Public ☐ Community

Comments / Conditions

INITIAL SITE SKETCH

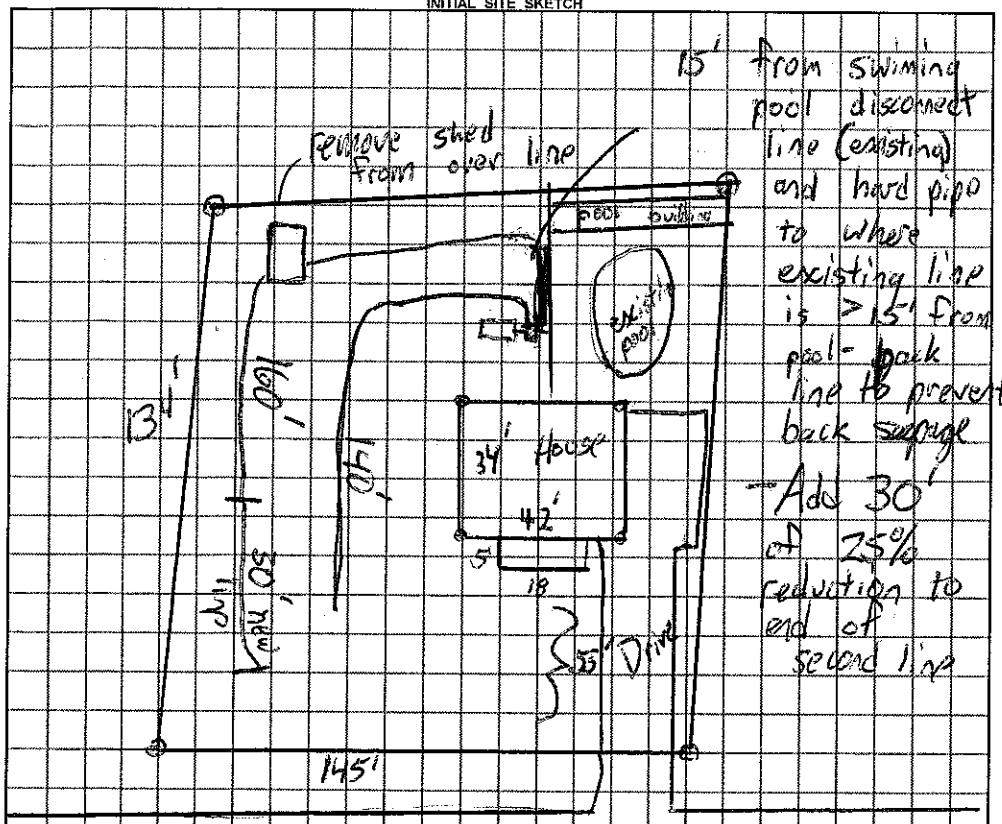


AS BUILT SKETCH

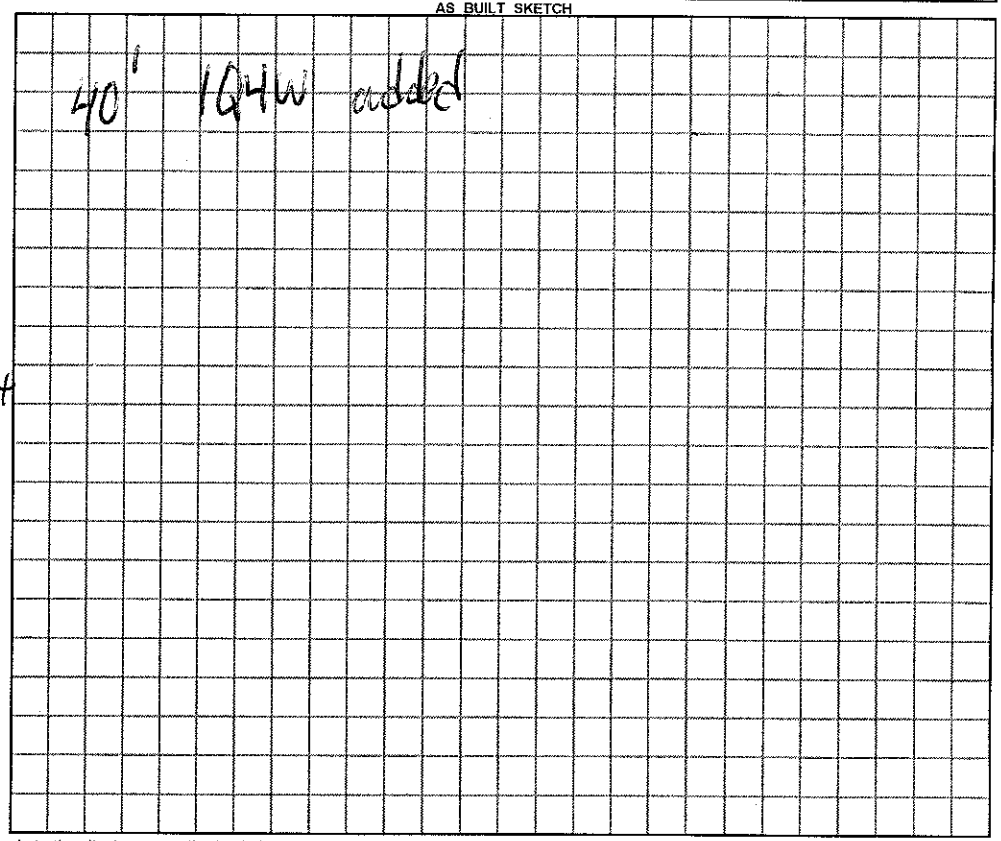


*Permit can be suspended or revoked if any false information is supplied toward securing the permit / any unauthorized changes are made to the site / any unauthorized changes are made in the installation of the system.*

☐ ***IMPROVEMENT PERMIT*** *with plat valid without expiration.* ☒ ***IMPROVEMENT PERMIT*** *with plat valid without expiration.* ☐ ***AUTHORIZATION TO CONSTRUCT*** valid for period equal to IMPROVEMENT PERMIT--not to exceed 60 mo.

Owner / Applicant Signature: Date 10-21-10 Installed by: Larry Tucker

IMPROVEMENT PERMIT by: REHS Date 10-21-10 OPERATION PERMIT by: REHS Date 2-28-11

AUTHORIZATION TO CONSTRUCT by: REHS Date 10-21-10 Existing System Inspected by: REHS Date

***YOU SHOULD CONTACT A LOCATOR SERVICE PRIOR TO ANY EXCAVATION***

White Copy – Environmental Health YELLOW COPY (Final) Owner / Applicant PINK COPY (Initial) Owner / Applicant